

WATER WELL PLUGGING RECORD Form WWC-5P

KSA 82a-1212

ID NO.

1 LOCATION OF WATER WELL: Fraction NE 1/4 NW 1/4 NE 1/4 Section Number 31 Township Number 27 Range Number 2 E W
 County: SEDGWICK

Distance and direction from nearest town or city street address of well if located within city?

2 WATER WELL OWNER: Jeffrey T. ErdmanRR#, St. Address, Box #: 3240 616 N. OakCity, State ZIP Code: Goddard, KS 67052

Global Positioning Systems (decimal degrees, min. of 4 digits)

Latitude: _____

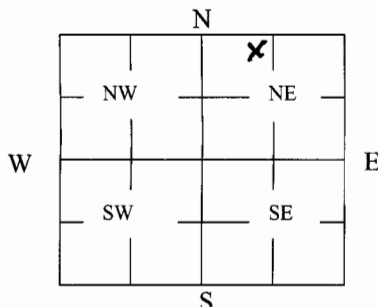
Longitude: _____

Elevation: _____

Datum: _____

Data Collection Method: _____

3 MARK WELL'S LOCATION WITH AN "X" IN SECTION BOX:

4 DEPTH OF WELL 35 ft.WELL'S STATIC WATER LEVEL 26 ft

WELL WAS USED AS:

☒ 1 Domestic☐ 2 Irrigation☐ 3 Feedlot☐ 4 Industrial☐ 5 Public Water Supply☐ 6 Oil Field Water Supply☐ 7 Domestic (Lawn & Garden)☐ 8 Air Conditioning☐ 9 Dewatering☐ 10 Monitoring☐ 11 Injection Well☐ 12 Other _____Was a chemical/bacteriological sample submitted to Department? Yes _____ No ☒

5 TYPE OF BLANK CASING USED:

☒ 1 Steel☐ 3 RMP (SR)☐ 5 Wrought☐ 7 Fiberglass☐ 9 Other (Specify below) _____☐ 2 PVC☐ 4 ABS☐ 6 Asbestos-Cement☐ 8 Concrete Tile _____Blank casing diameter 6 in. Was casing pulled? Yes _____ No ☒ If yes, how much _____

Casing height above or below land surface _____ in.

6 GROUT PLUG MATERIAL: ☐ 1 Neat cement ☒ 2 Cement grout ☐ 3 Bentonite ☐ 4 Other _____Grout Plug Intervals: From 3 ft. to top ft., From _____ ft. to _____ ft., From _____ to _____ ft.

What is the nearest source of possible contamination:

☐ 1 Septic tank☐ 6 Seepage pit☐ 11 Fuel Storage☐ 16 Other (specify below) _____☐ 2 Sewer lines☐ 7 Pit privy☐ 12 Fertilizer storage☒ 3 Watertight sewer lines☐ 8 Sewage lagoon☐ 13 Insecticide storage☐ 4 Lateral lines☐ 9 Feedyard☐ 14 Abandoned water well

Direction from well? _____

☐ 5 Cess pool☐ 10 Livestock pens☐ 15 Oil well/Gas well

How many feet? _____

FROM	TO	PLUGGING MATERIALS	FROM	TO	PLUGGING MATERIALS
<u>35'</u>	<u>32'</u>	<u>Bags of sand</u>	<u>32'</u>	<u>35'</u>	<u>Quik Crete Cement</u>
		<u>1 gallon clorox was added before</u>			<u>plugging was started,</u>

7 CONTRACTOR'S OR LANDOWNER'S CERTIFICATION: This water well was plugged under my jurisdiction and was completed on (mo/day/year) 08/19/2009 and this record is true to the best of my knowledge and belief. Kansas Water Well Contractor's License No. _____. This Water Well Record was completed on (mo/day/year) 08/19/2009 under the business name of owner by (signature) Reggie D. Erdman

INSTRUCTIONS: Use typewriter or ballpoint pen. Please press firmly and print clearly. Please fill in blanks, underline or circle the correct answers. Send top three copies to Kansas Department of Health and Environment, Bureau of Water, Geology Section, 1000 SW Jackson St., Ste. 420, Topeka, Kansas 66612-1367. Telephone: 785/296-5522. Send one to Water Well Owner and retain one for your records. Visit us at <http://www.kdheks.gov/geo/waterwells>.