

County: Sedgwick Fraction SE SE SE SE Sec. 27 T 27 S R 2 E(W)

CORRECTION(S) TO WATER WELL COMPLETION RECORD (WWC-5)

(to rectify lacking or incorrect information)

Owner: City of Wichita

Location was listed as:

Section-Township-Range: None Given

Fraction (1/4 1/4 1/4): _____

Location changed to:

27 - 27 S - 2 W

SE SE SE SE

Other changes: Initial statements: _____

Changed to: _____

Comments: _____

Verification method: written description and wellsite address, city street map, and mapping tool on KGS website.

initials: DRJ date: 9/28/2012

Submitted by: Kansas Geological Survey, Data Resources Library, 1930 Constant Ave., Lawrence, KS 66047-3726
to: Kansas Dept of Health & Environment, Bureau of Water, 1000 SW Jackson, Suite 420, Topeka, KS 66612-1367.

WATER WELL PLUGGING RECORD Form WWC-5P

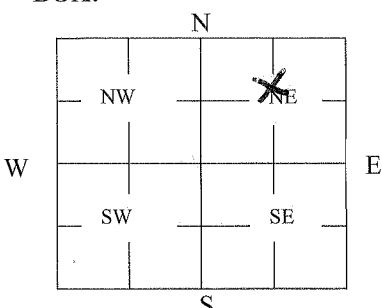
KSA 82a-1212 ID NO.

1 LOCATION OF WATER WELL: County: <u>Sedgwick</u>	Fraction $\frac{1}{4}$ $\frac{1}{4}$ $\frac{1}{4}$	Section Number	Township Number	Range Number E/W
--	---	----------------	-----------------	---------------------

Distance and direction from nearest town or city street address of well if located within city?

3 miles east of Goddard, KS. on Kellogg (15100 W. Kellogg)

2 WATER WELL OWNER: <u>City of Wichita</u> RR#, St. Address, Box #: <u>1900 E. 9th St.</u> City, State ZIP Code: <u>Wichita KS. 67214</u>	Global Positioning Systems (decimal degrees, min. of 4 digits) Latitude: _____ Longitude: _____ Elevation: _____ Datum: _____ Data Collection Method: _____
---	--

3 MARK WELL'S LOCATION WITH AN "X" IN SECTION BOX: 	4 DEPTH OF WELL <u>95</u> ft. WELL'S STATIC WATER LEVEL <u>20</u> ft. WELL WAS USED AS: ☒ 1 Domestic ☐ 2 Irrigation ☐ 3 Feedlot ☐ 4 Industrial ☐ 5 Public Water Supply ☐ 6 Oil Field Water Supply ☐ 7 Domestic (Lawn & Garden) ☐ 8 Air Conditioning ☐ 9 Dewatering ☐ 10 Monitoring ☐ 11 Injection Well ☐ 12 Other _____ Was a chemical/bacteriological sample submitted to Department? Yes _____ No _____
---	---

5 TYPE OF BLANK CASING USED: ☒ 1 Steel ☒ 2 PVC ☐ 3 RMP (SR) ☐ 4 ABS ☐ 5 Wrought ☐ 6 Asbestos-Cement ☐ 7 Fiberglass ☐ 8 Concrete Tile ☐ 9 Other (Specify below) _____	Blank casing diameter <u>4</u> in. Was casing pulled? Yes _____ No ☒ If yes, how much _____ Casing height above or below land surface <u>36</u> in. <u>below</u>
--	---

6 GROUT PLUG MATERIAL: ☒ 1 Neat cement ☐ 2 Cement grout ☐ 3 Bentonite ☐ 4 Other _____	Grout Plug Intervals: From <u>95</u> ft. to <u>3</u> ft., From _____ ft. to _____ ft., From _____ to _____ ft.																				
What is the nearest source of possible contamination: <table border="0"> <tr> <td>1 Septic tank</td> <td>6 Seepage pit</td> <td>11 Fuel Storage</td> <td>16 Other (specify below)</td> </tr> <tr> <td>2 Sewer lines</td> <td>7 Pit privy</td> <td>12 Fertilizer storage</td> <td><u>UNKNOWN</u></td> </tr> <tr> <td>3 Watertight sewer lines</td> <td>8 Sewage lagoon</td> <td>13 Insecticide storage</td> <td></td> </tr> <tr> <td>4 Lateral lines</td> <td>9 Feedyard</td> <td>14 Abandoned water well</td> <td>Direction from well? _____</td> </tr> <tr> <td>5 Cess pool</td> <td>10 Livestock pens</td> <td>15 Oil well/Gas well</td> <td>How many feet? _____</td> </tr>

FROM	TO	PLUGGING MATERIALS	FROM	TO	PLUGGING MATERIALS
<u>3ft.</u>	<u>95ft.</u>	<u>Neat Cement</u>			

7 CONTRACTOR'S OR LANDOWNER'S CERTIFICATION: This water well was plugged under my jurisdiction and was completed on (mo/day/year) 6-12-2012 and this record is true to the best of my knowledge and belief. Kansas Water Well Contractor's License No. _____. This Water Well Record was completed on (mo/day/year) 6-12-2012 under the business name of Wichita Excavation Inc. by (signature) Curtis P. Belbette Pres.

INSTRUCTIONS: Use typewriter or ballpoint pen. Please press firmly and print clearly. Please fill in blanks, underline or circle the correct answers. Send top three copies to Kansas Department of Health and Environment, Bureau of Water, Geology Section, 1000 SW Jackson St., Ste. 420, Topeka, Kansas 66612-1367. Telephone: 785/296-5522. Send one to Water Well Owner and retain one for your records. Visit us at <http://www.kdheks.gov/geo/waterwells>.