USE TYPEWRITER OR BALL POINT PEN-PRESS FIRMLY, PRINT CLEARLY.

WATER WELL RECORD
KSA 82a-1201-1215

Kansas Department of Health and Environment-Division of Environment
(Water well Contractors)
Topeka, Kansas 66620

1. Location of well:	County	Fraction	Section number	Township number	Range number
	Sedgwick	1/4 SE 1/4 SW 1/4	35	T 27 S	R 2 E (W)

2. Distance and direction from nearest town or city:
Street address of well location if in city: 14708 W. 23rd St. So. Wichita, Ks.

3. Owner of well: Greg Menges
R.R. or street: 16171 West Highway
City, state, zip code: Goddard, Kansas

4. Locate with "X" in section below: Sketch map:

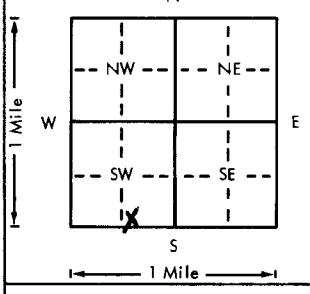

6. Bore hole dia. 11 in. Completion date
Well depth 90 ft. 8-20-76

7. __ Cable tool ✓ Rotary __ Driven __ Dug
__ Hollow rod __ Jetted __ Bored __ Reverse rotary

8. Use: ✓ Domestic __ Public supply __ Industry
__ Irrigation __ Air conditioning __ Stock
__ Lawn __ Oil field water __ Other

9. Casing: Material STYRENE Weight: (Above) or below
Threaded __ Welded GL Surface 12 in.
RMP ✓ PVC __ Weight __ lbs./ft.
Dia. 5 in. to 90 ft. depth Wall Thickness: inches or
Dia. __ in. to __ ft. depth gage No. 1200

5. Type and color of material	From	To
Topsoil	0	3
Clay	3	14
Fine Sand	14	17
Gray Shale	17	90
(Use a second sheet if needed)		

10. Screen: Manufacturer's name SUNFLOWER PLASTIC
Type STYRENE Dia. 5"
Slot/gauze 106 Length 65 ft
Set between 25 ft. and 90 ft.
ft. and ft.
Gravel pack YES Size range of material 1/4 - 1/8"

11. Static water level: mo./day/yr.
18 ft. below land surface Date 8-20-76

12. Pumping level below land surfaces:
ft. after hrs. pumping g.p.m.
ft. after hrs. pumping g.p.m.
Estimated maximum yield g.p.m.

13. Water sample submitted: mo./day/yr.
__ Yes __ No Date

14. Well head completion: Capped
__ Pitless adapter 12 Inches above grade

15. Well grouted? YES
With: __ Neat cement __ Bentonite ✓ Concrete
Depth: From 40 ft. to 14 ft.

16. Nearest source of possible contamination: Septic
ft. 75 Direction NE Type Tank
Well disinfected upon completion? ✓ Yes __ No

17. Pump: ✓ Not installed
Manufacturer's name
Model number HP Volts
Length of drop pipe ft. capacity g.p.m.
Type:
__ Submersible __ Turbine
__ Jet __ Reciprocating
__ Centrifugal __ Other

18. Elevation:
Topography:
__ Hill
✓ Slope
__ Upland
__ Valley

19. Remarks:

20. Water well contractor's certification:
This well was drilled under my jurisdiction and this report is true to the best of my knowledge and belief.
HARP Well & Pump 236
Business name License No.
Address WICHITA, KANSAS
Signed M. Arnell Date 8-31-76
Authorized representative

T 27 R 2 (W) Sec 35 1/4 1/4 1/4 SESW

Forward the white, blue and pink copies to the Department of Health and Environment

Form WWC-5

MI-1023