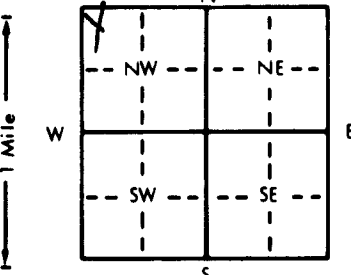


007269

WATER WELL RECORD Form WWC-5 KSA 82a-1212

1 LOCATION OF WATER WELL: County: <u>Sedgwick</u> Distance and direction from nearest town, or city street address of well if located within city? <u>734 N Goddard Rd, Goddard</u>		Fraction <u>NW 1/4 NW 1/4 NW 1/4</u>	Section Number <u>32</u>	Township Number <u>T 27 S</u>	Range Number <u>R 2</u> <u>W</u>
2 WATER WELL OWNER: RR#, St. Address, Box # : City, State, ZIP Code : <u>Prairie State Bank</u> <u>PO Box 520</u> <u>Augusta KS 67010</u>		Board of Agriculture, Division of Water Resources Application Number: <u>1458.33</u>			
<u>No</u> <u>X</u> ; If yes, mo/day/yr sample was submitted Water Well Disinfected? Yes <u>No</u> <u>X</u>			
, weight <u>70.3</u> lbs./ft. Wall thickness or gauge No. <u>3ch 40</u> TYPE OF SCREEN OR PERFORATION MATERIAL: 1 Steel 3 Stainless steel 5 Fiberglass 8 RMP (SR) 2 Brass 4 Galvanized steel 6 Concrete tile 9 ABS SCREEN OR PERFORATION OPENINGS ARE: 1 Continuous slot 3 Mill slot 2 Louvered shutter 4 Key punched SCREEN-PERFORATED INTERVALS: From <u>23</u> ft. to <u>38</u> ft.		5 Wrought iron 8 Concrete tile CASING JOINTS: Glued <u>Clamped</u> 6 Asbestos-Cement 9 Other (specify below) Welded <u>Threaded</u> <u>Flush</u> 7 Fiberglass 6 Concrete tile 9 ABS 5 Gauzed wrapped 8 Saw cut 11 None (open hole) 6 Wire wrapped 9 Drilled holes 7 Torch cut 10 Other (specify) 11 None (open hole)			
well/Gas well 3 Watertight sewer lines 6 Seepage pit 9 Feedyard 12 Fertilizer storage 16 Other (specify below) 13 Insecticide storage Direction from well? How many feet?		FROM TO LITHOLOGIC LOG FROM TO PLUGGING INTERVALS <u>0</u> <u>0.5</u> <u>Asphalt</u> <u>0.5</u> <u>13.5</u> <u>Clay, some sand</u> <u>13.5</u> <u>18.5</u> <u>Sandy clay</u> <u>18.5</u> <u>23</u> <u>Clayey sand</u> <u>23</u> <u>27.5</u> <u>Sandy clay</u> <u>27.5</u> <u>33.5</u> <u>Clayey sand</u> <u>33.5</u> <u>38</u> <u>Sand</u>			
7 CONTRACTOR'S OR LANDOWNER'S CERTIFICATION: This water well was <u>(1) constructed</u> , <u>(2) reconstructed</u> , or <u>(3) plugged</u> under my jurisdiction and was completed on (mo/day/year) <u>3/8/01</u> and this record is true to the best of my knowledge and belief. Kansas Water Well Contractor's License No. <u>531</u> This Water Well Record was completed on (mo/day/yr) <u>3/30/01</u> under the business name of <u>Geotechnical Services, Inc.</u> by (signature) <u>[Signature]</u>					

INSTRUCTIONS: Use typewriter or ball point pen. PLEASE PRESS FIRMLY and PRINT clearly. Please fill in blanks, underline or circle the correct answers. Send top three copies to Kansas Department of Health and Environment, Bureau of Water, Topeka, Kansas 66620-0001. Telephone: 913-296-5545. Send one to WATER WELL OWNER and retain one for your records.

OFFICE USE ONLY

T

R

E/W

SEC.

1/4

1/4

1/4