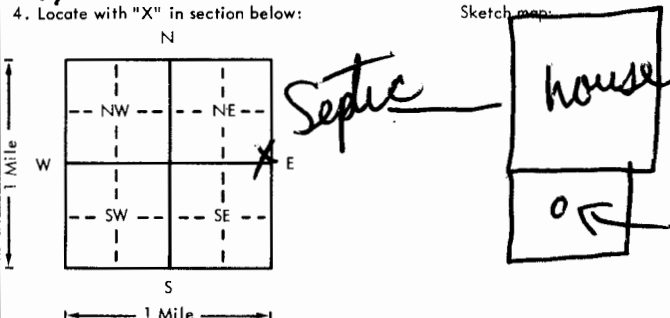


USE TYPEWRITER OR BALL
POINT PEN-PRESS FIRMLY,
PRINT CLEARLY.

WATER WELL RECORD
KSA 82a-1201-1215

Kansas Department of Health and
Environment-Division of Environment
(Water well Contractors)
Topeka, Kansas 66620

1. Location of well: County <u>Sedgewick</u> Fraction <u>SE 1/4 SE 1/4 NE 1/4</u> Section number <u>30</u> Township number <u>T 27 S</u> Range number <u>R 2 E</u>	
2. Distance and direction from nearest town or city: <u>1/2 mi. N. of Goodland KS.</u> Street address of well location if in city: <u>1133 So 199th West Goodland</u> 3. Owner of well: <u>Joyce Mathews</u> R.R. or street: <u>1133 So 199th West</u> City, state, zip code: <u>Goodland KS 67052</u>	
4. Locate with "X" in section below: Sketch map: 	
5. Type and color of material	
From	To
<u>Top soil /</u>	<u>0 2</u>
<u>gray clay.</u>	<u>2 34</u>
<u>fine to med. sand.</u>	<u>34 52</u>
<u>Charcoal shale</u>	<u>52 67</u>
6. Bore hole dia. <u>4</u> in. Completion date: <u>5/14/79</u> Well depth <u>67</u> ft.	
7. ☒ Cable tool ☒ Rotary ☐ Driven ☐ Dug ☐ Hollow rod ☒ Jetted ☐ Bored ☐ Reverse rotary	
8. Use: ☒ Domestic ☐ Public supply ☐ Industry ☐ Irrigation ☐ Air conditioning ☐ Stock ☐ Lawn ☐ Oil field water ☐ Other	
9. Casing: Material <u>Styrene</u> Height: <u>0</u> Above or below Threading: <u>Welded</u> Surface <u>12</u> in. RMP <u>X</u> PVC <u>X</u> Weight <u>1.50</u> lbs./ft. Dia. <u>5</u> in. to <u>67</u> ft. depth Wall Thickness: inches or Dia. <u>1</u> in. to <u>67</u> ft. depth gage No. <u>1200</u>	
10. Screen: Manufacturer's name <u>Sunflower</u> Type <u>200</u> Dia. <u>5</u> in. Slot gauge <u>1/16</u> Length <u>20</u> ft. Set between <u>47</u> ft. and <u>67</u> ft. Gravel pack <u>yes</u> Size range of material <u>3/8</u>	
11. Static water level: <u>30</u> ft. below land surface Date <u>5/14/79</u> mo./day/yr.	
12. Pumping level below land surfaces: <u>34</u> ft. after <u>12</u> hrs. pumping <u>15</u> g.p.m. <u>75</u> ft. after <u>1</u> hrs. pumping <u>15</u> g.p.m. Estimated maximum yield <u>20-35</u> g.p.m.	
13. Water sample submitted: <u>X</u> Yes <u>X</u> No Date <u>5/14/79</u> mo./day/yr.	
14. Well head completion: <u>12</u> Pitless adapter <u>12</u> inches above grade	
15. Well grouted? <u>yes</u> With: <u>Neat cement</u> <u>X</u> Bentonite <u>X</u> Concrete Depth: From <u>67</u> ft. to <u>16</u> ft.	
16. Nearest source of possible contamination: <u>75</u> ft. Direction <u>NW</u> Type <u>Septic</u> Well disinfected upon completion? <u>X</u> Yes <u> </u> No	
17. Pump: <u>X</u> Not installed Manufacturer's name <u> </u> Model number <u> </u> HP <u> </u> Volts <u> </u> Length of drop pipe <u> </u> ft. capacity <u> </u> g.p.m. Type: <u> </u> Submersible <u> </u> Turbine <u> </u> Jet <u> </u> Reciprocating <u> </u> Centrifugal <u> </u> Other	
(Use a second sheet if needed)	
18. Elevation:	19. Remarks: <u>New Construction</u>
Topography: ☒ Hill ☒ Slope ☐ Upland ☐ Valley	20. Water well contractor's certification: This well was drilled under my jurisdiction and this report is true to the best of my knowledge and belief. <u>Wynne Shelly</u> 318 Business name <u>Sedgewick KS</u> License No. <u> </u> Address <u> </u> Signed <u>Wynne Shelly</u> Date <u>5/14/79</u> Authorized representative

Forward the white, blue and pink copies to the Department of Health and Environment

Form WWC-5