USE TYPEWRITER OR BALL POINT PEN-PRESS FIRMLY, PRINT CLEARLY.

WATER WELL RECORD
KSA 82a-1201-1215

Kansas Department of Health and Environment-Division of Environment
(Water well Contractors)
Topeka, Kansas 66620

1. Location of well: County: Sedgwick | Fraction: SW 1/4 SW 1/4 SW 1/4 | Section number: 28 | Township number: T 27 S | Range number: R 2 E (W)

2. Distance and direction from nearest town or city: 1 East Goddard Ks -
Street address of well location if city:

3. Owner of well: GALAN Craig
R.R. or street: R#2
City, state, zip code: Goddard Ks 67052

4. Locate with "X" in section below:

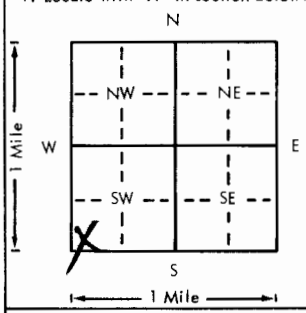

Sketch map:

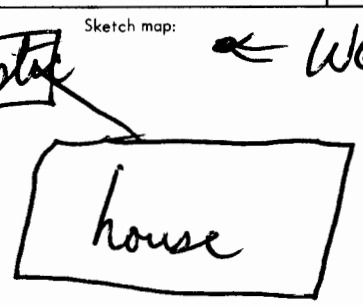

← well

6. Bore hole dia. ___ in. Completion date 10/1/78
Well depth 65 ft.

7. __ Cable tool X Rotary __ Driven __ Dug
__ Hollow rod __ Jetted __ Bored __ Reverse rotary

8. Use: X Domestic __ Public supply __ Industry
__ Irrigation __ Air conditioning __ Stock
__ Lawn __ Oil field water __ Other

9. Casing: Material Steel Weight Above or below
Threaded ___ Welded X Surface 12 in.
RMP X PVC ___ Weight 1.50 lbs./ft.
Dia. 5 in. to 65 ft. depth Wall Thickness: inches or
Dia. ___ in. to ___ ft. depth gage No. 1200

10. Screen: Manufacturer's name Sunflower
Type 200 Dia. 5in
Slot/gauze 1/16 Length 15
Set between 50 ft. and 65 ft.
___ ft. and ___ ft.
Gravel pack? yes Size range of material 3/8

11. Static water level:
25 ft. below land surface Date mo./day/yr. 10/1/78

12. Pumping level below land surfaces:
33 ft. after 1/2 hrs. pumping 10 g.p.m.
___ ft. after ___ hrs. pumping ___ g.p.m.
Estimated maximum yield 15-25 g.p.m.

13. Water sample submitted: mo./day/yr.
___ Yes X No Date ___

14. Well head completion:
___ Pitless adapter 12 inches above grade

15. Well grouted? yes
With: ___ Neat cement ___ Bentonite X Concrete
Depth: From 3 ft. to 13 ft.

16. Nearest source of possible contamination:
ft. 55 Direction West Type Septic
Well disinfected upon completion? X Yes ___ No

17. Pump: X Not installed
Manufacturer's name ___
Model number ___ HP ___ Volts ___
Length of drop pipe ___ ft. capacity ___ g.p.m.
Type:
___ Submersible ___ Turbine
___ Jet ___ Reciprocating
___ Centrifugal ___ Other

5. Type and color of material

	From	To
Top Soil	0	2
Red clay.	2	14
fine Sand	14	45
Green & red shale -	45	65

(Use a second sheet if needed)

18. Elevation:
Topography:
X Hill
___ Slope
___ Upland
___ Valley

19. Remarks:
Customer to furnish 4x4x4 slab around well at grade per State Regulations
Signed X Galan P. Craig

20. Water well contractor's certification:
This well was drilled under my jurisdiction and this report is true to the best of my knowledge and belief.
Business name Wenger Well License No. 318
Address Colwich Ks
Signed [signature] Date 10/1/78
Authorized representative

T 27 R 2 (W) Sec 28 1/4 1/4 1/4 1/4

Forward the white, blue and pink copies to the Department of Health and Environment

Form WWC-5

MI-1023