USE TYPEWRITER OR BALL POINT PEN-PRESS FIRMLY, PRINT CLEARLY.

WATER WELL RECORD
KSA 82a-1201-1215

Kansas Department of Health and Environment-Division of Environment
(Water well Contractors)
Topeka, Kansas 66620

| 1. Location of well: | County | Fraction | Section number | Township number | Range number |
|---|---|---|---|---|---|
| | Sedgwick | 1/4 SE 1/4 SE 1/4 | 27 | T 27 S | R 2W E/W |

2. Distance and direction from nearest town or city:
Street address of well location if in city: ¼ East and 200 yards North of 151st West

3. Owner of well:
R.R. or street: Jim Goolsby Construction 1349 Tapestry Circle
City, state, zip code: Wichita, Kansas

4. Locate with "X" in section below:

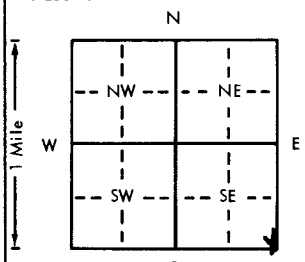


Sketch map:
and 54 hyway.
Wichita, Kansas

6. Bore hole dia. 11 in. Completion date
Well depth 105 ft. 7-12-77

7. __ Cable tool X Rotary __ Driven __ Dug
__ Hollow rod __ Jetted __ Bored __ Reverse rotary

8. Use: X Domestic __ Public supply __ Industry
__ Irrigation __ Air conditioning __ Stock
__ Lawn __ Oil field water __ Other

9. Casing: Material styrene Height: Above or below
Threaded __ Welded gl Surface 12 in.
RMP X PVC __ Weight __ lbs./ft.
Dia. 5 in. to 105 ft. depth Wall Thickness: inches or
Dia. __ in. to __ ft. depth gage No. .200

| 5. Type and color of material | From | To |
|---|---|---|
| Topsoil | 0 | 3 |
| Clay | 3 | 24 |
| Fine Sand | 24 | 30 |
| Shale(Gray) | 30 | 105 |

(Use a second sheet if needed)

10. Screen: Manufacturer's name Sunflower Plastic
Type styrene Dia. 5"
Slot/gauge .06 Length 74'
Set between 31 ft. and 105 ft.
ft. and ft.
Gravel pack? yes Size range of material ¼-1/8"

11. Static water level: mo./day/yr.
25 ft. below land surface Date 7-12-77

12. Pumping level below land surfaces:
ft. after hrs. pumping g.p.m.
ft. after hrs. pumping g.p.m.
Estimated maximum yield g.p.m.

13. Water sample submitted: mo./day/yr.
__ Yes __ No Date

14. Well head completion:
__ Pitless adapter 12 capped inches above grade

15. Well grouted? yes 1-2 fine sand mix
With: __ Neat cement __ Bentonite X Concrete
Depth: From 40 ft. to 14 ft.

16. Nearest source of possible contamination: NONE
ft. Direction Type
Well disinfected upon completion? X Yes __ No

17. Pump: X Not installed
Manufacturer's name
Model number HP Volts
Length of drop pipe ft. capacity g.p.m.
Type:
__ Submersible __ Turbine
__ Jet __ Reciprocating
__ Centrifugal __ Other

18. Elevation:

Topography:
X Hill
__ Slope
__ Upland
__ Valley

19. Remarks:
Septic system not installed when the well was drilled.
No apparent source for contamination.

20. Water well contractor's certification:
This well was drilled under my jurisdiction and this report is true to the best of my knowledge and belief.
Business name Harp Well & Pump 236 License No.
Address Wichita, Kansas 67209
Signed M. Arnold Date
Authorized representative 9-15-77

T 27 R 2W Sec 27 1/4 SE 1/4 SE 1/4

Forward the white, blue and pink copies to the Department of Health and Environment

Form WWC-5

MI-1023