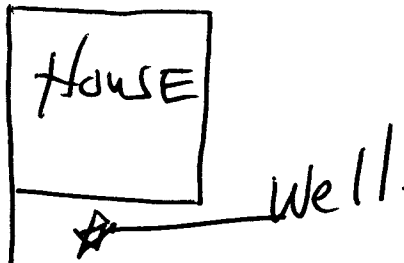


USE TYPEWRITER OR BALL
POINT PEN-PRESS FIRMLY,
PRINT CLEARLY.

WATER WELL RECORD
KSA 82a-1201-1215

Kansas Department of Health and
Environment-Division of Environment
(Water well Contractors)
Topeka, Kansas 66620

1. Location of well:	County: <u>Sedg.</u>	Fraction: <u>NW 1/4 SE 1/4 SE 1/4</u>	Section number: <u>25</u>	Township number: <u>T 27 S</u>	Range number: <u>R 2 W</u>
X Distance and direction from nearest town or city: Street address of well location if in city:			3. Owner of well: <u>Ben Carpenter</u> R.R. or street: <u>1444 Rogers</u> City, state, zip code: <u>Winifred KS 67235</u>		
4. Locate with "X" in section below: N W E S 1 Mile 1 Mile			Sketch map: 		
5. Type and color of material			From	To	
Top soil			0	6	
Red clay.			6	18	
fine sand.			18	24	
Red clay.			24	35	
dark bluish-green clay			35	75	
fine sand.			75	102	
medium gravel.			102	111	
clay			111	112	
(old well was graveled, closed and sealed off by cement at top 20 ft)					
18. Elevation:					
19. Remarks: Customer to furnish 4x4x4 rubber lined well at grade a pump installed at customer's residence State regulation Signed: <u>[Signature]</u>					
20. Water well contractor's certification: This well was drilled under my jurisdiction and this report is true to the best of my knowledge and belief. Business name: <u>Wenger Drilling</u> License No. <u>318</u> Address: <u>Edwicks KS</u> Signed: <u>[Signature]</u> Date: <u>11/12/77</u> Authorized representative					

Forward the white, blue and pink copies to the Department of Health and Environment

Form WWC-5