USE TYPEWRITER OR BALL POINT PEN-PRESS FIRMLY, PRINT CLEARLY.

WATER WELL RECORD
KSA 82a-1201-1215

Kansas Department of Health and Environment-Division of Environment
(Water well Contractors)
Topeka, Kansas 66620

1. Location of well: County: Sedg. Fraction: SW 1/4 NW 1/4 NE 1/4 Section number: 24 Township number: T 27 S Range number: R 2 (W)

2. Distance and direction from nearest town or city: 1 3/4 West of City limits Wichita
Street address of well location if in city: on Central Street.

3. Owner of well: Sherman Gipson
R.R. or street: 1360 N. Brunswick
City, state, zip code: Wichita KS. 67212

4. Locate with "X" in section below: Sketch map:

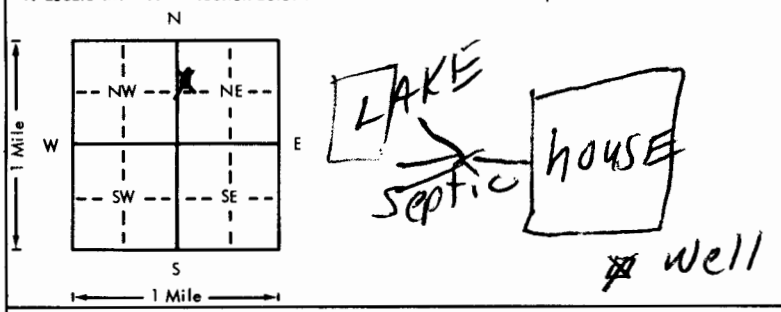

6. Bore hole dia. 10 in. Completion date
Well depth 63 ft. 6/21/76

7. __ Cable tool X Rotary __ Driven __ Dug
__ Hollow rod __ Jetted __ Bored __ Reverse rotary

8. Use: X Domestic __ Public supply __ Industry
__ Irrigation __ Air conditioning __ Stock
__ Lawn __ Oil field water __ Other

9. Casing: Material PVC Height: Above (circled) or below
Threaded ___ Welded ___ Surface 12 in.
RMP ___ PVC X Weight 2.31 lbs./ft.
Dia. 5 in. to 63 ft. depth Wall Thickness: inches or
Dia. ___ in. to ___ ft. depth gage No. 160 .214

10. Screw: Manufacturer's name Pumpco MPI
Type PVC Dia. 5 in.
Slot (circled) gauze 160 Length 5 ft.
Set between 58 ft. and 63 ft.
___ ft. and ___ ft.
Gravel pack? yes Size range of material 1/8-3/8

11. Static water level: mo./day/yr.
22 ft. below land surface Date 6/21/76

12. Pumping level below land surfaces:
28 ft. after 1/2 hrs. pumping 20 g.p.m.
___ ft. after ___ hrs. pumping ___ g.p.m.
Estimated maximum yield 100 g.p.m.

13. Water sample submitted: mo./day/yr.
__ Yes X No Date

14. Well head completion:
X Pitless adapter 12 Inches above grade

15. Well grouted? yes
With: X Neat cement __ Bentonite __ Concrete
Depth: From 3 ft. to 13 ft.

16. Nearest source of possible contamination:
ft. 400 Direction So. W Type Lake
Well disinfected upon completion? X Yes __ No

17. Pump: Not installed
Manufacturer's name Valley
Model number 1809 HP 3/4 Volt 220
Length of drop pipe 40 ft. capacity 20 g.p.m.
Type:
X Submersible __ Turbine
__ Jet __ Reciprocating
__ Centrifugal __ Other

5. Type and color of material	From	To
Top soil	0	4
Red clay	4	17
fine sand	17	31
Red clay	31	32
fine to course gravel	32	46
clay.	46	47
course gravel.	47	63

(Use a second sheet if needed)

18. Elevation:
Topography:
X Hill
__ Slope
__ Upland
__ Valley

19. Remarks: Customer to furnish 4x4x4 slab around well.

20. Water well contractor's certification:
This well was drilled under my jurisdiction and this report is true to the best of my knowledge and belief.
Business name Weninger Drl. License No. 1318
Address Colwich
Signed Jerome Weninger Date 6/25/76
Authorized representative

27 S 2 E W 24 Sec SW 1/4 NW 1/4 NE 1/4

Forward the white, blue and pink copies to the Department of Health and Environment

Form WWC-5

MI-1023