USE TYPEWRITER OR BALL POINT PEN-PRESS FIRMLY, PRINT CLEARLY.

T R EW sec 1/4 1/4 1/4 No.

WATER WELL RECORD
KSA 82a-1201-1215

Kansas State Dept. Of Health
(Water Well Contractors)
Forbes-Bldg. 740
Topeka, Kansas 66620

1 Location of well:	County	Township name	Fraction	Section number	Town number	Range number
	Sedg	Attica	NW NE NW	24	27S	2W.

Distance and direction from nearest town or city: 2 mile W Wichita limits on Central

Street address of well location if in city: 333 [redacted] Wheatland Pl

3 Owner of well: Biltmore Homes.

Address: 851 No West St Wichita Ks

Locate with "X" in section below:

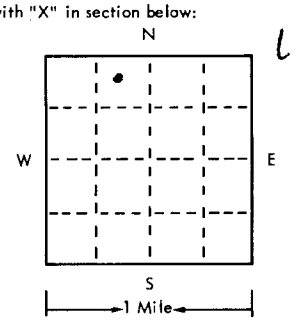

Sketch map:

2 Type and color of material	From	To
Top Soil	0	6
Red Clay	6	22
fine SAND	22	37
gravel	37	48
Red Clay	48	50

(use a second sheet if needed)

4 Well depth: 50 ft. Date of completion 9/23
Well diameter 5 in.

5 ☐ Cable tool ☑ Rotary ☐ Driven ☐ Dug
☐ Hollow rod ☐ Jetted ☐ Bored ☐ Reverse rotary

6 Use: ☑ Domestic ☐ Public supply ☐ Industry
☐ Irrigation ☐ Air conditioning ☐ Commercial
☐ Test well ☐ ____

7 Casing: Material PVC Height: above/below
Threaded ☐ Welded ☑ Surface 12 in.
Diam. Weight 1.55 lbs./ft. 1.00
5 in. to 50 ft. depth Drive shoe? ☐ Yes ☑ No
____ in. to ____ ft. depth

8 Screen:
Manufacturer Sunflower
Type plastic Dia. 5"
Slot/gauze 18 Length 6'
Set between 44 ft. and 50 ft.
Fittings:
Gravel pack ☑ Yes ☐ No Size range of material 3/8

9 Static water level:
24 ft. below land surface Date 9/23

10 Pumping level below land surfaces:
26 ft. after 1 hrs. pumping 18 g.p.m.
____ ft. after ____ hrs. pumping ____ g.p.m.
Estimated maximum yield 20 g.p.m.

11 Water sample submitted:
☐ Yes ☑ No Date ____

12 Well head completion:
☑ Pitless adapter 12 inches above grade

13 Well grouted? ☑ Yes ☐ No
☐ Neat cement ☐ Bentonite ☑ Concrete
Depth: From 3 ft. to 13 ft. MHC

14 Nearest source of possible contamination:
ft. ____ Direction NONE Type ____
Well disinfected upon completion? ☑ Yes ☐ No

15 Pump: ☐ Not installed
Manufacturer's name Valley
Model number 807 HP 1/2 Volts 230
Length of drop pipe 40 ft. capacity 15 g.m.p.
Type:
☑ Submersible ☐ Turbine
☐ Jet ☐ Reciprocating
☐ Centrifugal ☐ Other

16 Remarks: elevation

Topography:
☐ Hill
☐ Slope
☑ Upland
☐ Valley

17 Water well contractor's certification:
This well was drilled under my jurisdiction and this report is true to the best of my knowledge and belief.
Wenninger Drilling - 318
Business name License No.
Address 21 Colwich Ks
Signature [signature] Date 9/23
Authorized representative

27 2W 24 NW NE NW

Forward the white, blue and pink copies to the Kansas State Dept. Of Health.

Form WWC-5

677-H