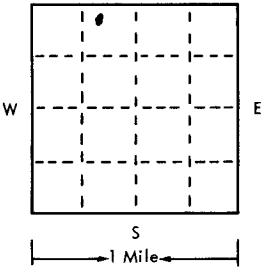
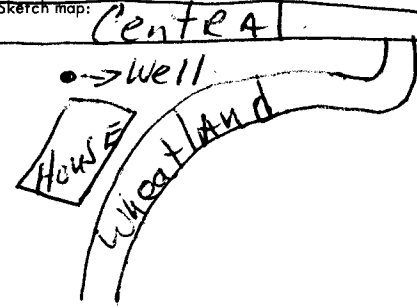


USE TYPEWRITER OR BALL
POINT PEN-PRESS FIRMLY,
PRINT CLEARLY.

WATER WELL RECORD
KSA 82a-1201-1215

T R EW sec 1/4 1/4 1/4 No.

Kansas State Dept. Of Health
(Water Well Contractors)
Forbes-Bldg. 740
Topeka, Kansas 66620

1 Location of well:	County <u>Sedg</u>	Township name <u>Attica</u>	Fraction <u>NWNE NW</u>	Section number <u>24</u>	Town number <u>27S</u>	Range number <u>2W</u>
Distance and direction from nearest town or city: <u>2 mile W with 1/4 limits on Central</u>			3 Owner of well: <u>Dennis Niedens</u> Address: <u>1821 No. Hickrest</u> <u>Goddard KS</u>			
Street address of well location if in city: <u>Wheatland Place</u>						
Locate with "X" in section below: 			Sketch map: 		4 Well depth: <u>50</u> ft. Date of completion <u>9/26</u> Well diameter <u>5</u> in.	
			5 ☐ Cable tool ☒ Rotary ☐ Driven ☐ Dug ☐ Hollow rod ☐ Jetted ☐ Bored ☐ Reverse rotary			
			6 Use: ☒ Domestic ☐ Public supply ☐ Industry ☐ Irrigation ☐ Air conditioning ☐ Commercial ☐ Test well ☐			
			7 Casing: Material <u>AMP</u> Height: above/below Threaded ☐ Welded ☒ Surface <u>12</u> in. Diam. <u>5</u> in. to <u>50</u> ft. depth Weight <u>150</u> lbs./100 Drive shoe? ☐ Yes ☒ No			
			8 Screen: <u>Sunflower</u> Manufacturer <u>Sunflower</u> Type <u>plastic</u> Dia. <u>5"</u> Slot/gauze <u>1/8</u> Length <u>Five ft</u> Set between <u>45</u> ft. and <u>50</u> ft. Fittings: <u>3/4</u> Gravel pack ☒ Yes ☐ No Size range of material <u>3/4</u>			
2 Type and color of material <u>Top Soil</u> <u>Red Clay</u> <u>fine sand</u> <u>GRAVEL</u> <u>Clay</u>			From		To	
			0 6		6 22	
			22 37		37 49	
			49 50			
			9 Static water level: <u>26</u> ft. below land surface Date <u>9/26</u>			
			10 Pumping level below land surfaces: <u>20</u> ft. after <u>1</u> hrs. pumping <u>18</u> g.p.m. ____ ft. after ____ hrs. pumping ____ g.p.m. Estimated maximum yield <u>100</u> g.p.m.			
			11 Water sample submitted: ☐ Yes ☒ No Date ____			
			12 Well head completion: ☒ Pitless adapter ☐ Inches above grade			
			13 Well grouted? ☒ Yes ☐ No ☐ Neat cement ☐ Bentonite ☒ Concrete Depth: From <u>3</u> ft. to <u>13</u> ft.			
			14 Nearest source of possible contamination: ft. ____ Direction <u>NE</u> Type ____ Well disinfected upon completion? ☒ Yes ☐ No			
			15 Pump: ☐ Not installed Manufacturer's name <u>Valley</u> Model number <u>1807</u> HP <u>1/2</u> Volts <u>220</u> Length of drop pipe <u>70</u> ft. capacity <u>15</u> g.p.m. Type: ☒ Submersible ☐ Turbine ☐ Jet ☐ Reciprocating ☐ Centrifugal ☐ Other			
16 Remarks: elevation			17 Water well contractor's certification: This well was drilled under my jurisdiction and this report is true to the best of my knowledge and belief. <u>Weninger Del</u> 318 Business name <u>Valley</u> License No. ____ Address <u>1 Church St.</u> Signed <u>[Signature]</u> Date <u>9/26</u> Authorized representative			

Forward the white, blue and pink copies to the Kansas State Dept. Of Health.

Form WWC-5