USE TYPEWRITER OR BALL POINT PEN-PRESS FIRMLY, PRINT CLEARLY.

WATER WELL RECORD
KSA 82a-1201-1215

Kansas Department of Health and Environment-Division of Environment
(Water well Contractors)
Topeka, Kansas 66620

1. Location of well:	County	Fraction	Section number	Township number	Range number
	Sedgwick	1/4 NW 1/4 NW 1/4	24	T 27 S	R 2W E/W

2. Distance and direction from nearest town or city:
Street address of well location if in city: 250 Rainbow Lakes Rd. Wichita, Kansas

3. Owner of well:
R.R. or street: Custom Care Builders 1211 North Richmond
City, state, zip code: Wichita, Kansas

4. Locate with "X" in section below:

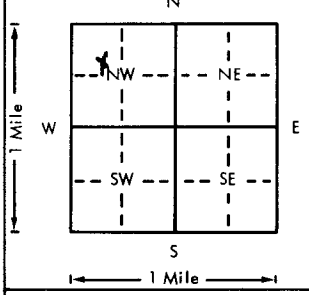

Sketch map: Well #1

6. Bore hole dia. 11 in. Completion date
Well depth 60 ft. 10-27-77

7. ___ Cable tool X Rotary ___ Driven ___ Dug
___ Hollow rod ___ Jetted ___ Bored ___ Reverse rotary

8. Use: X Domestic ___ Public supply ___ Industry
___ Irrigation ___ Air conditioning ___ Stock
___ Lawn ___ Oil field water ___ Other

9. Casing: Material styrene Height: Above or below
Threaded ___ Welded gl Surface 12 in.
RMP X PVC ___ Weight ___ lbs./ft.
Dia. 5 in. to 60 ft. depth Wall Thickness: inches or
Dia. ___ in. to ___ ft. depth gage No. .200

5. Type and color of material	From	To
Topsoil	0	3
Clay	3	23
Fine Sand	23	32
Medium Sand	32	60
(Use a second sheet if needed)		

10. Screen: Manufacturer's name Sunflower Plasti c
Type styrene Dia. 5"
Slot/gauge .06 Length 20'
Set between 40 ft. and 60 ft.
___ ft. and ___ ft.
Gravel pack? yes Size range of material 1/4-1/8"

11. Static water level: mo./day/yr.
20 ft. below land surface Date 10-27-77

12. Pumping level below land surfaces:
___ ft. after ___ hrs. pumping ___ g.p.m.
___ ft. after ___ hrs. pumping ___ g.p.m.
Estimated maximum yield ___ g.p.m.

13. Water sample submitted: mo./day/yr.
___ Yes ___ No Date

14. Well head completion:
X Pitless adapter 12 Inches above grade

15. Well grouted? yes 1-2 fine sand mix
With: ___ Neat cement ___ Bentonite X Concrete
Depth: From 40" ft. to 14 ft.

16. Nearest source of possible contamination: NONE
ft. ___ Direction ___ Type ___
Well disinfected upon completion? X Yes ___ No

17. Pump: ___ Not installed
Manufacturer's name Sta-Rite
Model number 20P4E02 HP 1 Volts 230
Length of drop pipe 50 ft. capacity 20 g.p.m.
Type:
X Submersible ___ Turbine
___ Jet ___ Reciprocating
___ Centrifugal ___ Other

18. Elevation:

Topography:
___ Hill
X Slope
___ Upland
___ Valley

19. Remarks:
Septic system not installed when the well was drilled.
No apparent source for contamination.

20. Water well contractor's certification:
This well was drilled under my jurisdiction and this report is true to the best of my knowledge and belief.
Harp Well & Pump 236
Business name Wichita, Kansas License No. 67209
Address
Signed M. Arnold Date 12-12-77
Authorized representative

27 - 2W - 24 NW NW NW
T R Sec 1/4 1/4 1/4

Forward the white, blue and pink copies to the Department of Health and Environment

Form WWC-5

MI-1023