USE TYPEWRITER OR BALL POINT PEN-PRESS FIRMLY, PRINT CLEARLY.

WATER WELL RECORD
KSA 82a-1201-1215

Kansas Department of Health and Environment-Division of Environment
(Water well Contractors)
Topeka, Kansas 66620

| 1. Location of well: | County | Fraction | Section number | Township number | Range number |
|---|---|---|---|---|---|
| | SEDGWICK | 1/4 SW 1/4 NW 1/4 | 24 | T 27 S | R 2W E/W |

2. Distance and direction from nearest town or city: 361 Rainbow Lakes Rd Wichita, Kansas
Street address of well location if in city:

Owner of well: Marilee Hines
R.R. or street: 361 Rainbow Lakes Rd.
City, state, zip code: Wichita, Kansas

4. Locate with "X" in section below:

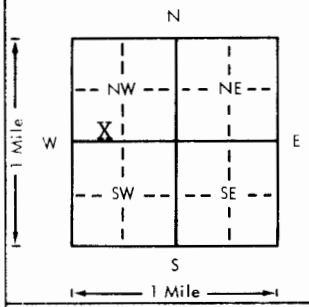


Sketch map:

6. Bore hole dia. 11 in. Completion date
Well depth 70 ft. 7-13-78

7. __ Cable tool X Rotary __ Driven __ Dug
__ Hollow rod __ Jetted __ Bored __ Reverse rotary

8. Use: __ Domestic __ Public supply __ Industry
__ Irrigation __ Air conditioning __ Stock
X Lawn __ Oil field water __ Other

9. Casing: Material Styrene Height: Above or below
Threaded ___ Welded gl Surface 12 in.
RMP X PVC ___ Weight ___ lbs./ft.
Dia. 5 in. to 70 ft. depth Wall Thickness: inches or
Dia. ___ in. to ___ ft. depth gage No. .200

| 5. Type and color of material | From | To |
|---|---|---|
| Topsoil | 0 | 3 |
| Clay | 3 | 20 |
| Fine Sand | 20 | 30 |
| Medium Sand | 30 | 70 |

(Use a second sheet if needed)

10. Screen: Manufacturer's name Sunflower Plastic
Type styrene Dia. 5"
Slot/gauze .06 Length 38'
Set between 32 ft. and 70 ft.
___ ft. and ___ ft.
Gravel pack? yes Size range of material ¼-1/8"

11. Static water level: mo./day/yr.
25 ft. below land surface Date 7-13-78

12. Pumping level below land surfaces:
___ ft. after ___ hrs. pumping ___ g.p.m.
___ ft. after ___ hrs. pumping ___ g.p.m.
Estimated maximum yield ___ g.p.m.

13. Water sample submitted: mo./day/yr.
___ Yes ___ No Date

14. Well head completion: capped
___ Pitless adapter 12 Inches above grade

15. Well grouted? ~~yes~~ 1-2Fine Sand Mix
With: ___ Neat cement ___ Bentonite X Concrete
Depth: From 40" ft. to 14 ft.

16. Nearest source of possible contamination: Septic
ft. 100 Direction West Type Tank
Well disinfected upon completion? X Yes ___ No

17. Pump: X Not installed
Manufacturer's name
Model number ___ HP ___ Volts ___
Length of drop pipe ___ ft. capacity ___ g.p.m.
Type:
___ Submersible ___ Turbine
___ Jet ___ Reciprocating
___ Centrifugal ___ Other

18. Elevation:
Topography:
___ Hill
___ Slope
___ Upland
___ Valley

19. Remarks: Flat Ground

20. Water well contractor's certification:
This well was drilled under my jurisdiction and this report is true to the best of my knowledge and belief.
Harp Well & Pump 236
Business name License No.
Address Wichita, Kansas 67209
Signed M. Arnold Date 8-1-78
Authorized representative

T 27 S R 2 W E Sec 24 1/4 SW 1/4 NW 1/4

Forward the white, blue and pink copies to the Department of Health and Environment

Form WWC-5

MI-1023