USE TYPEWRITER OR BALL POINT PEN-PRESS FIRMLY, PRINT CLEARLY.

WATER WELL RECORD
KSA 82a-1201-1215

Kansas Department of Health and Environment-Division of Environment
(Water well Contractors)
Topeka, Kansas 66620

1. Location of well:	County: Sedg.	Fraction: SE1/4 SW1/4 NW1/4	Section number: 20	Township number: T 27 S	Range number: R 2 E (W)

2. Distance and direction from nearest town or city: 2 1/2 No. Goddard KS.
Street address of well location if in city:

3. Owner of well: Harold J. Strunk
R.R. or street: Rt #1
City, state, zip code: Goddard KS 67052

4. Locate with "X" in section below:

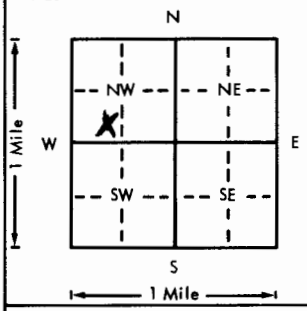

Sketch map:

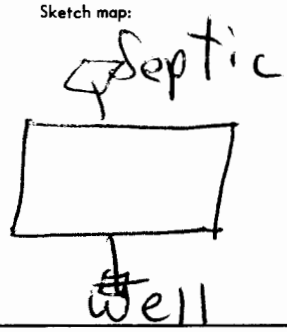

6. Bore hole dia. 8 in. Completion date
Well depth 65 ft. 2/27/76

7. __ Cable tool X Rotary __ Driven __ Dug
__ Hollow rod __ Jetted __ Bored __ Reverse rotary

8. Use: X Domestic __ Public supply __ Industry
__ Irrigation __ Air conditioning __ Stock
__ Lawn __ Oil field water __ Other

9. Casing: Material PVC Height: Above or below
Threaded ___ Welded X Surface 18 in.
RMP ___ PVC X Weight 2.00 lbs./ft.
Dia. 5 in. to 65 ft. depth Wall Thickness: inches or
Dia. ___ in. to ___ ft. depth gage No. 1.90

10. Screen: Manufacturer's name JTL
Type PVC Dia. 5 in.
Slot/gauze 1/8 Length 30 ft.
Set between 35 ft. and 65 ft.
___ ft. and ___ ft.
Gravel pack? yes Size range of material 3/8

11. Static water level: mo./day/yr.
25 ft. below land surface Date 2/27/76

12. Pumping level below land surfaces:
40 ft. after 1/2 hrs. pumping 20 g.p.m.
___ ft. after ___ hrs. pumping ___ g.p.m.
Estimated maximum yield ___ g.p.m.

13. Water sample submitted: mo./day/yr.
__ Yes X No Date

14. Well head completion:
X Pitless adapter ___ Inches above grade

15. Well grouted? yes
With: ___ Neat cement ✓ Bentonite ___ Concrete
Depth: From 3 ft. to 13 ft.

16. Nearest source of possible contamination:
ft. ___ Direction ___ Type ___
Well disinfected upon completion? X Yes ___ No

17. Pump: Not installed
Manufacturer's name Valley
Model number 1807 HP 1/2 Volts 230
Length of drop pipe 40 ft. capacity 20 g.p.m.
Type:
X Submersible ___ Turbine
___ Jet ___ Reciprocating
___ Centrifugal ___ Other

5. Type and color of material

From	To
0	6
6	18
18	25
25	65

Top Soil
Red clay
fine sand
gray shale

(Use a second sheet if needed)

18. Elevation:

Topography:
X Hill
___ Slope
___ Upland
___ Valley

19. Remarks: Mr. Strunk to pour 4x4x4 slab at grade to comply with State regulations

20. Water well contractor's certification:
This well was drilled under my jurisdiction and this report is true to the best of my knowledge and belief.
Business name Wenger Drilling License No. 318
Address Colwich KS
Signed Jerome Wenger Date
Authorized representative 2/27/76

T 27 R 2 (W) Sec 20 SE SW NW 1/4 1/4 1/4

Forward the white, blue and pink copies to the Department of Health and Environment

Form WWC-5

MI-1023