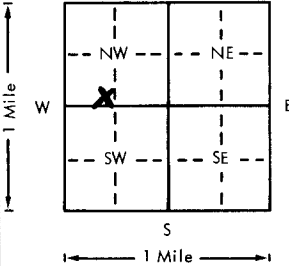
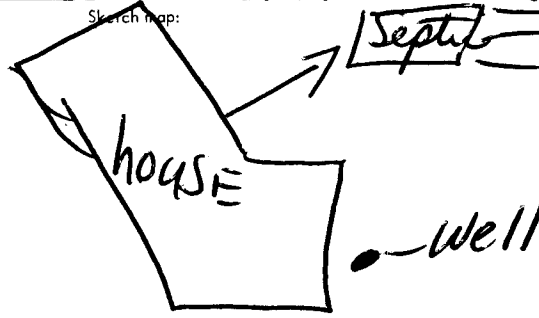


USE TYPEWRITER OR BALL
POINT PEN-PRESS FIRMLY,
PRINT CLEARLY.

WATER WELL RECORD
KSA 82a-1201-1215

Kansas Department of Health and
Environment-Division of Environment
(Water well Contractors)
Topeka, Kansas 66620

1. Location of well: <u>Sedgwick Co. SE 1/4 SW 1/4 NW 1/4</u>		Section number <u>20</u>		Township number <u>T 27 S</u>		Range number <u>R 2 E</u>	
2. Distance and direction from nearest town or city: <u>1 1/2 mile No Goodhard Ks</u>		3. Owner of well: <u>Harold Strunk</u>		Street address of well location if in city: <u>RR #1 Goodhard Ks - 67052</u>			
4. Locate with "X" in section below:		Sketch map:		6. Bore hole dia. <u>1 1/2</u> in. Completion date <u>5/15/78</u>			
				Well depth <u>78</u> ft.			
5. Type and color of material		From		To		7. Cable tool ☒ Rotary ☐ Driven ☐ Dug	
<u>Top soil.</u>		<u>0</u>		<u>3</u>		☐ Hollow rod ☐ Jetted ☐ Bored ☐ Reverse rotary	
<u>Red clay</u>		<u>3</u>		<u>22</u>		8. Use: ☒ Domestic ☐ Public supply ☐ Industry	
<u>fine sand</u>		<u>22</u>		<u>28</u>		☐ Irrigation ☐ Air conditioning ☐ Stock	
<u>charcoal shale</u>		<u>28</u>		<u>58</u>		☐ Lawn ☐ Oil field water ☐ Other	
<u>blue-green shale</u>		<u>58</u>		<u>63</u>		9. Casing: Material <u>Steel</u> ☒ Above or below	
<u>charcoal shale</u>		<u>63</u>		<u>78</u>		Threaded ☐ Welded ☒ Surface <u>1 1/2</u> in.	
						RMP ☒ PVC ☐ Weight <u>1.50</u> lbs./ft.	
						Dia. <u>5</u> in. to <u>78</u> ft. depth Wall Thickness: inches or	
						Dia. <u>5</u> in. to <u>78</u> ft. depth Gauge No. <u>1200</u>	
						10. Screen: Manufacturer's name <u>Sunflower</u>	
						Type <u>200</u> Dia. <u>5</u> in.	
						Slot gauge <u>1/16</u> Length <u>50</u> ft.	
						Set between <u>28</u> ft. and <u>78</u> ft.	
						Gravel pack? <u>yes</u> Size range of material <u>3/8</u>	
						11. Static water level: <u>13</u> ft. below land surface Date <u>5/15/78</u>	
						12. Pumping level below land surfaces:	
						<u>70</u> ft. after <u>1/2</u> hrs. pumping <u>8</u> g.p.m.	
						<u>70</u> ft. after <u>1/2</u> hrs. pumping <u>8</u> g.p.m.	
						Estimated maximum yield <u>8-9</u> g.p.m.	
						13. Water sample submitted: <u>Yes</u> ☒ No ☐ Date <u>5/15/78</u>	
						14. Well head completion:	
						☒ Pitless adapter <u>12</u> inches above grade	
						15. Well grouted? <u>yes</u>	
						With: <u>Neat cement</u> ☐ Bentonite ☒ Concrete	
						Depth: From <u>3</u> ft. to <u>13</u> ft.	
						16. Nearest source of possible contamination: <u>250</u> ft. Direction <u>No.</u> Type <u>Pond</u>	
						Well disinfected upon completion? ☒ Yes ☐ No	
						17. Pump:	
						Manufacturer's name <u>Valley</u> Not installed	
						Model number <u>12501</u> HP <u>1/2</u> Vol <u>220</u>	
						Length of drop pipe <u>70</u> ft. capacity <u>12</u> g.p.m.	
						Type:	
						☒ Submersible ☐ Turbine	
						☐ Jet ☐ Reciprocating	
						☐ Centrifugal ☐ Other	
18. Elevation:		19. Remarks:		20. Water well contractor's certification:			
Topography: ☒ Hill ☐ Slope ☐ Upland ☐ Valley		<u>Customer to furnish 4'x4'x4' slab around casing at grade per State Regulations</u>		This well was drilled under my jurisdiction and this report is true to the best of my knowledge and belief.			
		<u>Signed X H. Strunk</u>		Business name <u>Weninger Drilling</u> License No. <u>318</u>			
				Address <u>Polwich</u>			
				Signed <u>J. Weninger</u> Date <u>5/15/78</u>			
				Authorized representative			

Forward the white, blue and pink copies to the Department of Health and Environment

Form WWC-5