


1 LOCATION OF WATER WELL: Fraction SW 1/4 NW 1/4 SW 1/4 Section Number 20 Township Number T 27 S Range Number R 2 E (W)
 County: Sedgewick
 Distance and direction from nearest town or city street address of well if located within city?


2 WATER WELL OWNER: Steve Lee
 RR#, St. Address, Box #: 6110 Bell Rd.
 City, State, ZIP Code: WK 67002
 Board of Agriculture, Division of Water Resources
 Application Number:

3 LOCATE WELL'S LOCATION WITH AN "X" IN SECTION BOX:

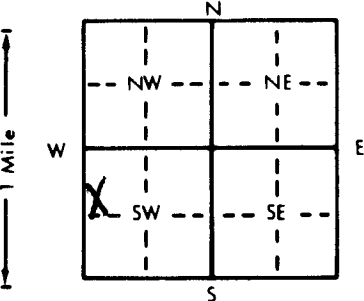

4 DEPTH OF COMPLETED WELL: 60 ft. ELEVATION: 5-12-82
 Depth(s) Groundwater Encountered 1. 28 ft. 2. 35 ft. 3. 42 ft.
 WELL'S STATIC WATER LEVEL 28 ft. below land surface measured on mo/day/yr 5-12-82
 Pump test data: Well water was 35 ft. after 12 hours pumping 20 gpm
 Est. Yield 30 gpm; Well water was 35 ft. after 12 hours pumping 20 gpm
 Bore Hole Diameter 11 in. to 60 ft., and 60 in. to 60 ft.

WELL WATER TO BE USED AS:
☒ Domestic 3 Feedlot 6 Oil field water supply 9 Dewatering 12 Other (Specify below)
☐ 2 Irrigation 4 Industrial 7 Lawn and garden only 10 Observation well

Was a chemical/bacteriological sample submitted to Department? Yes (No); If yes, mo/day/yr sample was submitted

Water Well Disinfected? Yes (No) No

5 TYPE OF BLANK CASING USED:

1 Steel 5 RMP (SR) 5 Wrought iron 8 Concrete tile CASING JOINTS: Glued Clamped
 2 PVC 4 ABS 6 Asbestos-Cement 9 Other (specify below) Welded
 7 Fiberglass Threaded

Blank casing diameter 5 in. to 30 ft., Dia. 12 in. to 30 ft., Dia. 1.59 lbs./ft. Wall thickness or gauge No. 3DR-20

TYPE OF SCREEN OR PERFORATION MATERIAL:

1 Steel 3 Stainless steel 5 Fiberglass 8 RMP (SR) 10 Asbestos-cement
 2 Brass 4 Galvanized steel 6 Concrete tile 9 ABS 11 Other (specify)
 12 None used (open hole)

SCREEN OR PERFORATION OPENINGS ARE:

1 Continuous slot 3 Mill slot 5 Gauzed wrapped 8 Saw cut 11 None (open hole)
 2 Louvered shutter 4 Key punched 6 Wire wrapped 9 Drilled holes
 7 Torch cut 10 Other (specify)

SCREEN-PERFORATED INTERVALS: From 30 ft. to 60 ft., From 60 ft. to 60 ft.

GRAVEL PACK INTERVALS: From 15 ft. to 60 ft., From 60 ft. to 60 ft.

FROM 15 ft. to 60 ft., FROM 60 ft. to 60 ft.

6 GROUT MATERIAL: 1 Neat cement 2 Cement grout 3 Bentonite 4 Other

Grout Intervals: From 5 ft. to 15 ft., From 15 ft. to 60 ft., From 60 ft. to 60 ft.

What is the nearest source of possible contamination:

1 Septic tank 4 Lateral lines 7 Pit privy 10 Livestock pens 14 Abandoned water well
 2 Sewer lines 5 Cess pool 8 Sewage lagoon 11 Fuel storage 15 Oil well/Gas well
 3 Watertight sewer lines 6 Seepage pit 9 Feedyard 12 Fertilizer storage 16 Other (specify below)
 13 Insecticide storage

Direction from well? East How many feet? 150

FROM TO LITHOLOGIC LOG FROM TO LITHOLOGIC LOG

0 2 Top soil 0 2 Top soil

2 18 Red clay 2 18 Red clay

18 39 med. sand 18 39 med. sand

39 60 Red + Blue gray shale 39 60 Red + Blue gray shale



7 CONTRACTOR'S OR LANDOWNER'S CERTIFICATION: This water well was (1) constructed, (2) reconstructed, or (3) plugged under my jurisdiction and was completed on (mo/day/year) 5-12-82 and this record is true to the best of my knowledge and belief. Kansas

Water Well Contractor's License No. 318 This Water Well Record was completed on (mo/day/yr) 5-20-82
 under the business name of Weninger Drilling by (signature) Weninger

INSTRUCTIONS: Use typewriter or ball point pen, PLEASE PRESS FIRMLY and PRINT clearly. Please fill in blanks, underline or circle the correct answers. Send top three copies to Kansas Department of Health and Environment, Division of Environment, Environmental Geology Section, Topeka, KS 66620. Send one to WATER WELL OWNER and retain one for your records.

X JUL 1 1982

OFFICE USE ONLY

T

27

R

2

E

SEC.

20

SW 1/4

NW 1/4

SW 1/4