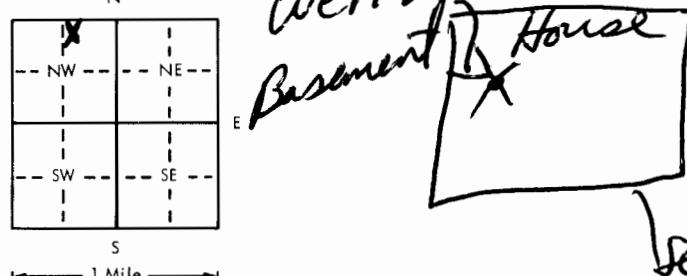


USE TYPEWRITER OR BALL
POINT PEN-PRESS FIRMLY,
PRINT CLEARLY.

WATER WELL RECORD
KSA 82a-1201-1215

Kansas Department of Health and
Environment-Division of Environment
(Water well Contractors)
Topeka, Kansas 66620

1. Location of well:	County: <u>Sedgwick</u>	Fraction: <u>NW 1/4 NE 1/4 NW 1/4</u>	Section number: <u>22</u>	Township number: <u>T 27 S</u>	Range number: <u>R 2 E</u>
2. Distance and direction from nearest town or city: <u>6 mile So 1/4 E Colwich KS.</u>			3. Owner of well: <u>Dale M. Martin</u> R.R. or street: <u>R#1 Box 65-B-2</u> City, state, zip code: <u>Colwich KS 67030</u>		
4. Locate with "X" in section below: N W E S 1 Mile Sketch map: 			6. Bore hole dia. <u>11</u> in. Completion date: <u>4/24/79</u> Well depth <u>80</u> ft.		
			7. ☒ Cable tool ☒ Rotary ☐ Driven ☐ Dug ☐ Hollow rod ☐ Jetted ☐ Bored ☐ Reverse rotary		
			8. Use: ☒ Domestic ☐ Public supply ☐ Industry ☐ Irrigation ☐ Air conditioning ☐ Stock ☐ Lawn ☐ Oil field water ☐ Other		
			9. Casing: Material <u>Styrene</u> Height <u>0</u> Above or below Threaded ☐ Welded ☒ Surface <u>13</u> in. RMP ☒ PVC Weight <u>1.50</u> lbs./ft. Dia. <u>5</u> in. <u>80</u> ft. depth Wall Thickness: inches or Dia. <u>5</u> in. to <u>80</u> ft. depth Gauge No. <u>1200</u>		
5. Type and color of material			From	To	10. Screen: Manufacturer's name <u>Sunflower</u>
<u>Top soil</u>			<u>0</u>	<u>2</u>	Type <u>200</u> Dia. <u>5</u>
<u>Red clay</u>			<u>2</u>	<u>17</u>	Slot gauge <u>1 1/8</u> Length <u>49</u> ft.
<u>fine sand</u>			<u>17</u>	<u>24</u>	Set between <u>28</u> ft. and <u>77</u> ft.
<u>blue-green shale</u>			<u>24</u>	<u>43</u>	Gravel pack <u>yes</u> Size range of material <u>1/8-3/8</u>
<u>charcoal shale</u>			<u>43</u>	<u>64</u>	11. Static water level: <u>33</u> ft. below land surface Date <u>4/24/79</u>
<u>brown shale</u>			<u>64</u>	<u>68</u>	12. Pumping level below land surfaces: <u>65</u> ft. after <u>1/2</u> hrs. pumping <u>8</u> g.p.m.
<u>charcoal shale</u>			<u>68</u>	<u>80</u>	<u>65</u> ft. after <u>1/2</u> hrs. pumping <u>8</u> g.p.m.
					Estimated maximum yield <u>10-15</u> g.p.m.
					13. Water sample submitted: <u>Yes</u> ☒ No ☐ Date <u>4/24/79</u>
					14. Well head completion: <u>12</u> Pitless adapter <u>12</u> Inches above grade
					15. Well grouted? <u>yes</u> With: <u>Neat cement</u> ☐ Bentonite ☒ Concrete ☐ Depth: From <u>6</u> ft. to <u>16</u> ft.
					16. Nearest source of possible contamination: ft. <u>80</u> Direction <u>So.</u> Type <u>Septic</u> Well disinfected upon completion? ☒ Yes ☐ No
					17. Pump: ☒ Not installed Manufacturer's name _____ Model number _____ HP _____ Volts _____ Length of drop pipe _____ ft. capacity _____ g.p.m. Type: ☐ Submersible ☐ Turbine ☐ Jet ☐ Reciprocating ☐ Centrifugal ☐ Other
(Use a second sheet if needed)					
18. Elevation:	19. Remarks: <u>NEW Construction</u>		20. Water well contractor's certification: This well was drilled under my jurisdiction and this report is true to the best of my knowledge and belief. <u>Wenger Drilling 318</u> Business name <u>Sedgwick KS</u> License No. _____ Address <u>Colwich KS</u> Signature <u>Wenger</u> 4/24/79 Authorized representative		

Forward the white, blue and pink copies to the Department of Health and Environment

Form WWL-5