USE TYPEWRITER OR BALL POINT PEN-PRESS FIRMLY, PRINT CLEARLY.

WATER WELL RECORD
KSA 82a-1201-1215

Kansas Department of Health and Environment-Division of Environment
(Water well Contractors)
Topeka, Kansas 66620

1. Location of well:	County: Sedgwick	Fraction: SE 1/4 SW 1/4 NE 1/4	Section number: 17	Township number: T 27 S	Range number: R 2 E (W)

2. Distance and direction from nearest town or city: 1 E 2 1/2 No Goddard Ks.
Street address of well location if in city: 18800 W. 9th.

3. Owner of well: Ralph Landwehr
R.R. or street: R #2
City, state, zip code: Goddard Ks 67052

4. Locate with "X" in section below:

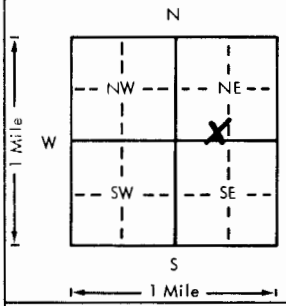

Sketch map:

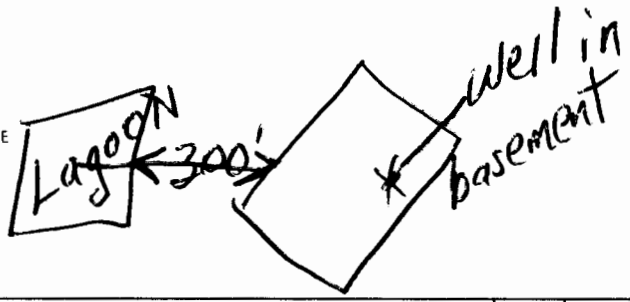

6. Bore hole dia. 11 in. Completion date 9/26/78
Well depth 78 ft.

7. __ Cable tool X Rotary __ Driven __ Dug
__ Hollow rod __ Jetted __ Bored __ Reverse rotary

8. Use: X Domestic __ Public supply __ Industry
__ Irrigation __ Air conditioning __ Stock
__ Lawn __ Oil field water __ Other

9. Casing: Material: Styrene Weight Above or below
Threaded __ Welded X Surface 12 in.
RMP X PVC __ Weight 1.50 lbs./ft.
Dia. 5 in. to 78 ft. depth Wall Thickness: inches or
Dia. __ in. to __ ft. depth gage No. 1200

5. Type and color of material

	From	To
Top soil.	0	3
Red clay.	3	33
fine sand	33	40
charcoal shale -	40	78

(Use a second sheet if needed)

10. Screen: Manufacturer's name Sunflower
Type 200 Dia. 5 in.
Slot gauze 1/16 Length 35 ft
Set between 43 ft. and 78 ft.
__ ft. and __ ft.
Gravel pack? yes Size range of material 3/8

11. Static water level: mo./day/yr.
24 ft. below land surface Date 9/26/78

12. Pumping level below land surfaces:
33 ft. after 1/2 hrs. pumping 10 g.p.m.
__ ft. after __ hrs. pumping __ g.p.m.
Estimated maximum yield 15-20 g.p.m.

13. Water sample submitted: mo./day/yr.
__ Yes X No Date

14. Well head completion:
__ Pitless adapter 12 Inches above grade

15. Well grouted? yes
With: __ Neat cement __ Bentonite X Concrete
Depth: From 6 ft. to 16 ft.

16. Nearest source of possible contamination:
ft 300 Direction W Type Lagoon
Well disinfected upon completion? X Yes __ No

17. Pump: X Not installed
Manufacturer's name
Model number HP Volts
Length of drop pipe ft. capacity g.p.m.
Type:
__ Submersible __ Turbine
__ Jet __ Reciprocating
__ Centrifugal __ Other

T 27 S R 2 (W) Sec 17 SE SW NE 1/4 1/4 1/4

18. Elevation:

Topography:
X Hill
__ Slope
__ Upland
__ Valley

19. Remarks:

20. Water well contractor's certification:
This well was drilled under my jurisdiction and this report is true to the best of my knowledge and belief.
Weninger Drilling 318
Business name License No.
Address Colwich Ks
Signed Authorized representative Date 9/26/78

Forward the white, blue and pink copies to the Department of Health and Environment

Form WWC-5

MI-1023