


**WATER WELL RECORD Form WWC-5 KSA 82a-1212**

<b>1</b> LOCATION OF WATER WELL: <b>Sedgwick</b>	FRACTION <b>NW 1/4 SW 1/4 SE 1/4</b>	SECTION NUMBER <b>11</b>	TOWNSHIP NUMBER <b>T 27 S</b>	RANGE NUMBER <b>R 2W E/W</b>
---	---	-----------------------------	----------------------------------	---------------------------------

Distance and direction from nearest town or city street address of well if located within city?  
**1431 N. Stout Ct. Wichita, Kansas**

<b>2</b> WATER WELL OWNER: <b>SHORES, Brad</b> RR#, ST. ADDRESS, BOX #: <b>1431 N. Stout Ct.</b> CITY, STATE: <b>Wichita, Kansas</b>	Board of Agriculture, Division of Water Resource Application Number:
--	---

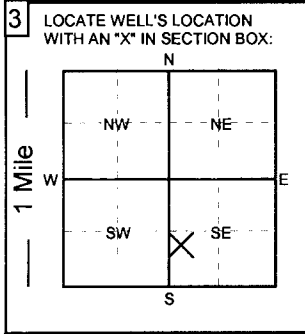

**4** DEPTH OF COMPLETED WELL: **70** ft. ELEVATION:

Depth of groundwater Encountered: \_\_\_\_\_ ft.

WELL'S STATIC WATER LEVEL: **28** FT. BELOW LAND SURFACE MEASURED ON **5/23/14** mo/day/yr:

Pump test data: Well water was \_\_\_\_\_ ft. after \_\_\_\_\_ hours of pumping @ \_\_\_\_\_ gpm  
 Est. Yield: \_\_\_\_\_ gpm Well water was \_\_\_\_\_ ft. after \_\_\_\_\_ hours of pumping @ \_\_\_\_\_ gpm

Bore Hole Diameter **12** in. to **70** ft. and \_\_\_\_\_ in. to \_\_\_\_\_ ft.

WELL WATER TO BE USED AS:  
 1. Domestic    3. Feedlot    5. Public water supply    **7. Lawn and garden only**    9. Dewatering    11. Injection well  
 2. Irrigation    4. Industrial    6. Oil field water supply    8. Air conditioning    10. Monitoring well    12. Other (Specify below)

Was a chemical/bacteriological sample submitted to Department? **YES** **NO**; If yes, what mo/day/yr was sample submitted \_\_\_\_\_  
 Was Water Well Disinfected? **YES** **NO**

**5** TYPE OF CASING USED:

1. Steel    3. RPM (SR)    5. Wrought Iron    7. Fiberglass    9. Other (Specify below)    CASING JOINTS: **Glued**    Threaded  
 2. **PVC**    4. ABS    6. Asbestos-Cement    8. Concrete tile    SDR-26    Welded    Clamped

Blank casing diameter **5** in. to **50** ft., Dia. \_\_\_\_\_ in. to \_\_\_\_\_ ft., Dia. \_\_\_\_\_ in. to \_\_\_\_\_ ft.

Casing height above land surface: **12** in., Weight: **2.35** lbs. / ft. Wall thickness or gauge No. **.214**

TYPE OF SCREEN OR PERFORATION MATERIAL:  
 1. Steel    3. Stainless Steel    5. Fiberglass    **7. PVC**    9. ABS    11. Other (specify) \_\_\_\_\_  
 2. Brass    4. Galvanized    6. Concrete Tile    8. RMP (SR)    10. Asbestos-Cement    12. None used (open hole)

SCREEN OR PERFORATION OPENINGS ARE:  
 1. Continuous slot    3. Mill slot    5. Gauzed wrapped    7. Torch cut    9. Drilled holes    11. None (open hole)  
 2. Louvered shutter    4. Key punched    6. Wire wrapped    **8. Saw cut**    10. Other (specify) \_\_\_\_\_

SCREEN - PERFORATION INTERVAL    From **50** ft. to **70** ft.,    From \_\_\_\_\_ ft. to \_\_\_\_\_ ft.  
 \_\_\_\_\_ ft. to \_\_\_\_\_ ft.,    From \_\_\_\_\_ ft. to \_\_\_\_\_ ft.

GRAVEL PACK INTERVALS:    From **24** ft. to **70** ft.,    From \_\_\_\_\_ ft. to \_\_\_\_\_ ft.  
 \_\_\_\_\_ ft. to \_\_\_\_\_ ft.,    From \_\_\_\_\_ ft. to \_\_\_\_\_ ft.

**6** GROUT MATERIALS:    1. Neat cement    2. Cement Grout    3. Bentonite    Other **bentonite hole plug**

Grout Intervals:    From **4** ft. to **24** ft.,    From \_\_\_\_\_ ft. to \_\_\_\_\_ ft.,    From \_\_\_\_\_ ft. to \_\_\_\_\_ ft.

What is the nearest source of possible contamination:  
 1. Septic tank    4. Lateral lines    7. Pit privy    10. Livestock pens    13. Insecticide storage    15. Oil well/Gas well  
 2. Sewer lines    5. Cess Pool    8. Sewage lagoon    11. Fuel storage    14. Abandon water well    16. Other (specify below) \_\_\_\_\_  
**3. Watertight sewer line**    6. Seepage pit    9. Feed yard    12. Fertilizer storage

Direction from well? **North**    How many feet? **10 ft. plus**

From	To	LITHOLOGIC LOG	From	To	LITHOLOGIC LOG
0	3	topsoil			
3	34	clay			
34	50	fine sand			
50	70	medium sand			

**7** Contractor's or Landowner's Certification: This water well was **1. constructed** 2. reconstructed or 3. plugged under my jurisdiction and was completed on (mo/day/year) **5/23/2014** and this record is true to the best of my knowledge and belief.

Kansas Water Well Contractor's License No. **236**    This water well record was completed on (mo/day/year) **5/30/2014**  
 under the business name of **Harp Well and Pump Service**    by (signature) **Todd S. Harp**