


WATER WELL RECORD Form WWC-5 KSA 82a-1212

1 LOCATION OF WATER WELL: Sedgwick	FRACTION NW 1/4 SW 1/4 NE 1/4	SECTION NUMBER 11	TOWNSHIP NUMBER T 27 S	RANGE NUMBER R 2W E/W
--	---	-----------------------------	----------------------------------	---------------------------------

Distance and direction from nearest town or city street address of well if located within city?
Reserve D, Behind Lot 71, Blk D. Wichita, Kansas

2 WATER WELL OWNER: SILVERTON HOA	Board of Agriculture, Division of Water Resource	Application Number:
RR#, ST. ADDRESS, BOX #: 716 N 119th W. #112	ZIP CODE:	
CITY, STATE: Wichita, Kansas		

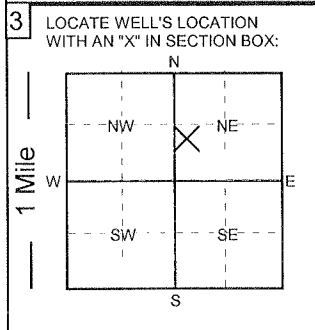

4 DEPTH OF COMPLETED WELL: 67 ft.	ELEVATION:
Depth of groundwater Encountered: _____ ft.	_____ ft.
WELL'S STATIC WATER LEVEL 30 FT. BELOW LAND SURFACE MEASURED ON 10/6/14	
Pump test data: Well water was _____ ft. after _____ hours of pumping @ _____ gpm	
Est. Yield: _____ gpm	Well water was _____ ft. after _____ hours of pumping @ _____ gpm
Bore Hole Diameter 12 in. to 67 ft. and _____ in. to _____ ft.	
WELL WATER TO BE USED AS:	
1. Domestic 3. Feedlot 5. Public water supply 7. Lawn and garden only 9. Dewatering 11. Injection well	12. Other (Specify below)
2. Irrigation 4. Industrial 6. Oil field water supply 8. Air conditioning 10. Monitoring well	
Was a chemical/bacteriological sample submitted to Department? YES NO ; If yes, what mo/day/yr was sample submitted	Was Water Well Disinfected? YES NO

5 TYPE OF CASING USED:	CASING JOINTS: Glued Threaded
1. Steel 3. RPM (SR) 5. Wrought Iron 7. Fiberglass 9. Other (Specify below)	Welded Clamped
2. PVC 4. ABS 6. Asbestos-Cement 8. Concrete tile SDR-26	
Blank casing diameter 5 in. to 47 ft., Dia. in. to ft., Dia. in. to ft.	
Casing height above land surface: 12 in., Weight: 2.35 lbs. / ft. Wall thickness or gauge No. .214	
TYPE OF SCREEN OR PERFORATION MATERIAL:	
1. Steel 3. Stainless Steel 5. Fiberglass 7. PVC 9. ABS 11. Other (specify)	
2. Brass 4. Galvanized 6. Concrete Tile 8. RMP (SR) 10. Asbestos-Cement 12. None used (open hole)	
SCREEN OR PERFORATION OPENINGS ARE:	
1. Continuous slot 3. Mill slot 5. Gauzed wrapped 7. Torch cut 9. Drilled holes 11. None (open hole)	
2. Louvered shutter 4. Key punched 6. Wire wrapped 8. Saw cut 10. Other (specify)	
SCREEN - PERFORATION INTERVAL	From 47 ft. to 67 ft., From _____ ft. to _____ ft.
GRAVEL PACK INTERVALS:	From 24 ft. to 67 ft., From _____ ft. to _____ ft.

6 GROUT MATERIALS:	Other bentonite hole plug
1. Neat cement 2. Cement Grout 3. Bentonite	
Grout Intervals: From 4 ft. to 24 ft., From _____ ft. to _____ ft., From _____ ft. to _____ ft.	
What is the nearest source of possible contamination:	
1. Septic tank 4. Lateral lines 7. Pit privy 10. Livestock pens 13. Insecticide storage 15. Oil well/Gas well	
2. Sewer lines 5. Cess Pool 8. Sewage lagoon 11. Fuel storage 14. Abandon water well 16. Other (specify below)	
3. Watertight sewer line 6. Seepage pit 9. Feed yard 12. Fertilizer storage	
Direction from well? South	How many feet? 10 ft. plus

From	To	LITHOLOGIC LOG	From	To	LITHOLOGIC LOG
0	3	topsoil			
3	38	clay			
38	45	fine sand			
45	65	medium sand			
65	67	clay			

7 Contractor's or Landowner's Certification: This water well was 1. constructed 2. reconstructed or 3. plugged under my jurisdiction and was completed on (mo/day/year) 10/6/14 and this record is true to the best of my knowledge and belief.	This water well record was completed on (mo/day/year) 10/8/2014
Kansas Water Well Contractor's License No. 236 under the business name of Harp Well and Pump Service	by (signature) Todd S. Harp

KG
Per
Har
2/20