


WATER WELL RECORD Form WWC-5

Original Record Correction Change in Well Use

Division of Water Resources App. No. Township Number Range Number

1 LOCATION OF WATER WELL: County: Sedgwick Fraction SW 1/4 NW 1/4 SE 1/4 SW 1/4 Section Number 11 Township Number T 27 S Range Number R 2 E W

2 WELL OWNER: Last Name: FRENTZ First: BUDDY Street or Rural Address where well is located (if unknown, distance and direction from nearest town or intersection): If at owner's address, check here: [X]

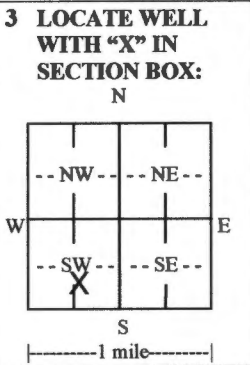

4 DEPTH OF COMPLETED WELL: 110 ft. Depth(s) Groundwater Encountered: 1) 37 ft. 2) 37 ft. 3) 37 ft. or 4) Dry Well

5 Latitude: 37.709819 (decimal degrees) Longitude: 97.51249996 (decimal degrees) Datum: [X] WGS 84 [X] NAD 83 [] NAD 27

7 WELL WATER TO BE USED AS: 1. Domestic: [X] Household [X] Lawn & Garden [] Livestock 2. [] Irrigation 3. [] Feedlot 4. [] Industrial

Was a chemical/bacteriological sample submitted to KDHE? [] Yes [X] No If yes, date sample was submitted: Water well disinfected? [X] Yes [] No

8 TYPE OF CASING USED: [] Steel [X] PVC [] Other CASING JOINTS: [X] Glued [] Clamped [] Welded [] Threaded Casing diameter 5 in. to 110 ft., Diameter 12 in. to 26 ft., Diameter 12 in. to 26 ft., Diameter 12 in. to 26 ft.

TYPE OF SCREEN OR PERFORATION MATERIAL: [] Steel [] Stainless Steel [] Fiberglass [X] PVC [] Other (Specify) [] Brass [] Galvanized Steel [] Concrete tile [] None used (open hole) SCREEN OR PERFORATION OPENINGS ARE: [] Continuous Slot [X] Mill Slot [] Gauze Wrapped [] Torch Cut [] Drilled Holes [] Other (Specify) [] Louvered Shutter [] Key Punched [] Wire Wrapped [] Saw Cut [] None (Open Hole)

9 GROUT MATERIAL: [] Neat cement [] Cement grout [X] Bentonite [] Other Grout Intervals: From 4 ft. to 24 ft., From 24 ft. to 110 ft., From 110 ft. to 110 ft., From 110 ft. to 110 ft.

Nearest source of possible contamination: [] Septic Tank [] Lateral Lines [] Pit Privy [] Livestock Pens [] Insecticide Storage [] Sewer Lines [] Cess Pool [] Sewage Lagoon [] Fuel Storage [] Abandoned Water Well [X] Watertight Sewer Lines [] Seepage Pit [] Feedyard [] Fertilizer Storage [] Oil Well/Gas Well [] Other (Specify) Direction from well? NORTH Distance from well? 30 ft.

Table with 6 columns: 10 FROM, TO, LITHOLOGIC LOG, FROM, TO, LITHO. LOG (cont.) or PLUGGING INTERVALS. Rows include TOPSOIL (0-3), CLAY (3-46), FINE SAND (46-61), MEDIUN SAND (61-88), COARSE SAND (88-110).

Notes:

11 CONTRACTOR'S OR LANDOWNER'S CERTIFICATION: This water well was [X] constructed, [] reconstructed, or [] plugged under my jurisdiction and was completed on (mo-day-year) 10/22/2015 and this record is true to the best of my knowledge and belief. Kansas Water Well Contractor's License No. 611. This Water Well Record was completed on (mo-day-year) 11/10/2015 under the business name of Chase Drilling.