


WATER WELL RECORD Form WWC-5 KSA 82a-1212

1 LOCATION OF WATER WELL: Sedgwick	FRACTION SW 1/4 NE 1/4 NW 1/4	SECTION NUMBER 13	TOWNSHIP NUMBER T 27 S	RANGE NUMBER R 2W E/W
--	---	-----------------------------	----------------------------------	---------------------------------

Distance and direction from nearest town or city street address of well if located within city?
1277 N. Forestview Ct. Wichita, Kansas

2 WATER WELL OWNER: KLAUSMEYER CONSTRUCTION	RR#,ST. ADDRESS,BOX #: 10008 W. York	CITY, STATE: Wichita, Kansas	ZIP CODE: 	Application Number:
---	--	--	----------------------	--------------------------------

Board of Agriculture, Division of Water Resource

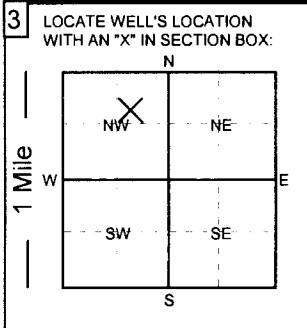

4 DEPTH OF COMPLETED WELL: 68 ft.	ELEVATION: ft.
Depth of groundwater Encountered: ft.	 ft.
WELL'S STATIC WATER LEVEL 26 FT. BELOW LAND SURFACE MEASURED ON 4/25/16	 mo/day/yr:
Pump test data: Well water was ft. after hours of pumping @ gpm	
Est. Yield: gpm	Well water was ft. after hours of pumping @ gpm
Bore Hole Diameter 12 in. to 68 ft. and in. to ft.	
WELL WATER TO BE USED AS:	
1. Domestic	3. Feedlot
5. Public water supply	7. Lawn and garden only
9. Dewatering	11. Injection well
2. Irrigation	4. Industrial
6. Oil field water supply	8. Air conditioning
10. Monitoring well	12. Other (Specify below)
Was a chemical/bacteriological sample submitted to Department? YES NO ; If yes, what mo/day/yr was sample submitted 	
Was Water Well Disinfected? YES NO	

5 TYPE OF CASING USED:	5. Wrought Iron	7. Fiberglass	9. Other (Specify below)	CASING JOINTS:	Glued	Threaded
1. Steel	3. RPM (SR)	6. Asbestos-Cement	8. Concrete tile	SDR-26	Welded	Clamped
2. PVC	4. ABS					
Blank casing diameter 5 in. to 48 ft., Dia. in. to ft., Dia. in. to ft.						
Casing height above land surface: 12 in., Weight: 2.35 lbs. / ft. Wall thickness or gauge No. .214						
TYPE OF SCREEN OR PERFORATION MATERIAL:						
1. Steel	3. Stainless Steel	5. Fiberglass	7. PVC	9. ABS	11. Other (specify)	
2. Brass	4. Galvanized	6. Concrete Tile	8. RMP (SR)	10. Asbestos-Cement	12. None used (open hole)	
SCREEN OR PERFORATION OPENINGS ARE:						
1. Continuous slot	3. Mill slot	5. Gauzed wrapped	7. Torch cut	9. Drilled holes	11. None (open hole)	
2. Louvered shutter	4. Key punched	6. Wire wrapped	8. Saw cut	10. Other (specify)		
SCREEN - PERFORATION INTERVAL	From 48 ft. to 68 ft.,	From ft. to ft.,	From ft. to ft.,	From ft. to ft.,	From ft. to ft.,	From ft. to ft.
GRAVEL PACK INTERVALS:	From 24 ft. to 68 ft.,	From ft. to ft.,	From ft. to ft.,	From ft. to ft.,	From ft. to ft.,	From ft. to ft.

6 GROUT MATERIALS:	1. Neat cement	2. Cement Grout	3. Bentonite	Other bentonite hole plug
Grout Intervals: From 4 ft. to 24 ft.,	From ft. to ft.,	From ft. to ft.,	From ft. to ft.,	From ft. to ft.
What is the nearest source of possible contamination:				
1. Septic tank	4. Lateral lines	7. Pit privy	10. Livestock pens	13. Insecticide storage
2. Sewer lines	5. Cess Pool	8. Sewage lagoon	11. Fuel storage	14. Abandon water well
3. Watertight sewer line	6. Seepage pit	9. Feed yard	12. Fertilizer storage	15. Oil well/Gas well
Direction from well? West				How many feet? 20 ft. plus

From	To	LITHOLOGIC LOG	From	To	LITHOLOGIC LOG
0	3	topsoil			
3	20	clay			
20	40	fine sand			
40	65	medium sand			
65	68	clay			

7 Contractor's or Landowner's Certification: This water well was 1. **constructed** 2. reconstructed or 3. plugged under my jurisdiction and was completed on (mo/day/year) **4/25/16** and this record is true to the best of my knowledge and belief.

Kansas Water Well Contractor's License No. **236** This water well record was completed on (mo/day/year) **4/27/16**

under the business name of **Harp Well and Pump Service** by (signature) **Todd S. Harp**