

**WATER WELL RECORD Form WWC-5**

Original Record  Correction  Change in Well Use


Division of Water Resources App. No.  

Well ID  

526

**1 LOCATION OF WATER WELL:** County: Sedgewick Fraction: NE 1/4 NE 1/4 SE 1/4 NE 1/4 Section Number: 11 Township Number: T 27 S Range Number: R 2 E W

**2 WELL OWNER:** Last Name: Crumley First: Steve Street or Rural Address where well is located (if unknown, distance and direction from nearest town or intersection): If at owner's address, check here:   
 Business Address: 14305 W. Willoughby  
 City: Wichita State: Ko ZIP: 67235

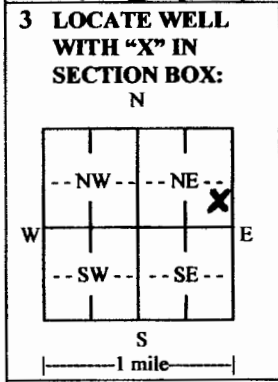

**4 DEPTH OF COMPLETED WELL:** 80 ft.  
 Depth(s) Groundwater Encountered: 1) 33 ft. 2)   ft. 3)   ft. or 4)  Dry Well  
 WELL'S STATIC WATER LEVEL: 33 ft.  
 below land surface, measured on (mo-day-yr)  
 above land surface, measured on (mo-day-yr) 8-4-15  
 Pump test data: Well water was   ft. after   hours pumping   gpm  
 Well water was   ft. after   hours pumping   gpm  
 Estimated Yield: 20 gpm  
 Bore Hole Diameter: 12 in. to 80 ft. and   in. to   ft.

**5 Latitude:** 37.717617 (decimal degrees)  
**Longitude:** 97.4996681 (decimal degrees)  
 Datum:  WGS 84  NAD 83  NAD 27  
 Source for Latitude/Longitude:  
 GPS (unit make/model:  ) (WAAS enabled?  Yes  No)  
 Land Survey  Topographic Map  
 Online Mapper:  

**7 WELL WATER TO BE USED AS:**

1. Domestic:  Household  Lawn & Garden  Livestock  
 2. Irrigation  Feedlot  Industrial  
 3.  Public Water Supply: well ID    
 4.  Dewatering: how many wells?    
 5.  Aquifer Recharge: well ID    
 6.  Monitoring: well ID    
 7. Environmental Remediation: well ID    
 Air Sparge  Soil Vapor Extraction  Recovery  Injection  
 8.  Oil Field Water Supply: lease    
 9. Test Hole: well ID    
 Cased  Uncased  Geotechnical  
 10. Geothermal: how many bores?    
 a) Closed Loop  Horizontal  Vertical  
 b) Open Loop  Surface Discharge  Inj. of Water  
 11.  Other (specify):  

Was a chemical/bacteriological sample submitted to KDHE?  Yes  No If yes, date sample was submitted:    
 Water well disinfected?  Yes  No

**8 TYPE OF CASING USED:**  Steel  PVC  Other   CASING JOINTS:  Glued  Clamped  Welded  Threaded  
 Casing diameter 5 in. to 80 ft., Diameter   in. to   ft., Diameter   in. to   ft.  
 Casing height above land surface 12 in. Weight 160 lbs./ft. Wall thickness or gauge No. 26

TYPE OF SCREEN OR PERFORATION MATERIAL:  
 Steel  Stainless Steel  Fiberglass  PVC  Other (Specify)    
 Brass  Galvanized Steel  Concrete tile  None used (open hole)

SCREEN OR PERFORATION OPENINGS ARE:  
 Continuous Slot  Mill Slot  Gauze Wrapped  Torch Cut  Drilled Holes  Other (Specify)    
 Louvered Shutter  Key Punched  Wire Wrapped  Saw Cut  None (Open Hole)

SCREEN-PERFORATED INTERVALS: From 60 ft. to 80 ft., From   ft. to   ft., From   ft. to   ft.  
 GRAVEL PACK INTERVALS: From 24 ft. to 80 ft., From   ft. to   ft., From   ft. to   ft.

**9 GROUT MATERIAL:**  Neat cement  Cement grout  Bentonite  Other    
 Grout Intervals: From 4 ft. to 24 ft., From   ft. to   ft., From   ft. to   ft.

Nearest source of possible contamination:  
 Septic Tank  Lateral Lines  Pit Privy  Livestock Pens  Insecticide Storage  
 Sewer Lines  Cess Pool  Sewage Lagoon  Fuel Storage  Abandoned Water Well  
 Watertight Sewer Lines  Seepage Pit  Feedyard  Fertilizer Storage  Oil Well/Gas Well  
 Other (Specify)    
 Direction from well? South Distance from well? 25 ft.

10 FROM	TO	LITHOLOGIC LOG	FROM	TO	LITHO. LOG (cont.) or PLUGGING INTERVALS
0	2	Top Soil			
2	33	Clay			
33	55	fine-sand			
55	80	med-sand			
			Notes:		

**11 CONTRACTOR'S OR LANDOWNER'S CERTIFICATION:** This water well was  constructed,  reconstructed, or  plugged under my jurisdiction and was completed on (mo-day-year) 8-4-15, and this record is true to the best of my knowledge and belief. Kansas Water Well Contractor's License No. 6611 This Water Well Record was completed on (mo-day-year) 9-1-15 under the business name of Chase Drilling

INSTRUCTIONS: Send one copy to WATER WELL OWNER and retain one copy for your records. Submit fee of \$5.00 for each constructed well along with one (white) copy to Kansas Department of Health and Environment, Bureau of Water, Geology Section, 1000 SW Jackson St., Suite 420, Topeka, Kansas 66612-1367. Telephone (785) 296-3565.