


## WATER WELL RECORD Form WWC-5 KSA 82a-1212

1 LOCATION OF WATER WELL: <b>Sedgwick</b>	FRACTION <b>SW 1/4 NE 1/4 SW 1/4</b>	SECTION NUMBER <b>28</b>	TOWNSHIP NUMBER <b>T 27 S</b>	RANGE NUMBER <b>R 2W E/W</b>
--	---	-----------------------------	----------------------------------	---------------------------------

Distance and direction from nearest town or city street address of well if located within city?  
**1005 N. Oakridge Goddard, Kansas**

2 WATER WELL OWNER: <b>KLAYSMEYER CONSTRUCTION</b>	Board of Agriculture, Division of Water Resource
RR#, ST. ADDRESS, BOX #: <b>10008 W York</b>	Application Number:
CITY, STATE: <b>Wichita, Kansas</b>	ZIP CODE:

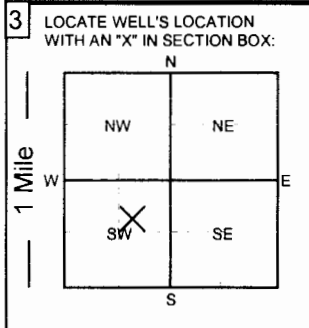

4 DEPTH OF COMPLETED WELL: <b>80</b> ft.	ELEVATION:
Depth of groundwater Encountered: _____ ft.	_____ ft.
WELL'S STATIC WATER LEVEL: <b>30</b> FT. BELOW LAND SURFACE MEASURED ON <b>7/13/16</b>	_____ mo/day/yr.
Pump test data: Well water was _____ ft. after _____ hours of pumping @ _____ gpm	
Est. Yield: _____ gpm	Well water was _____ ft. after _____ hours of pumping @ _____ gpm
Bore Hole Diameter <b>12</b> in. to <b>80</b> ft. and _____ in. to _____ ft.	
WELL WATER TO BE USED AS:	
1. Domestic 3. Feedlot 5. Public water supply <b>7. Lawn and garden only</b> 9. Dewatering 11. Injection well	12. Other (Specify below)
2. Irrigation 4. Industrial 6. Oil field water supply 8. Air conditioning 10. Monitoring well	
Was a chemical/bacteriological sample submitted to Department? <b>YES</b> <b>NO</b> ; If yes, what mo/day/yr was sample submitted	
Was Water Well Disinfected? <b>YES</b> <b>NO</b>	

5 TYPE OF CASING USED:		5. Wrought Iron	7. Fiberglass	9. Other (Specify below)	CASING JOINTS: <b>Glued</b> Threaded
1. Steel	3. RPM (SR)				Welded Clamped
<b>2. PVC</b>	4. ABS	6. Asbestos-Cement	8. Concrete tile	SDR-26	
Blank casing diameter <b>5</b> in. to <b>35</b> ft., Dia. _____ in. to _____ ft., Dia. _____ in. to _____ ft.					
Casing height above land surface: <b>12</b> in., Weight: <b>2.35</b> lbs. / ft.				Wall thickness or gauge No. <b>.214</b>	
TYPE OF SCREEN OR PERFORATION MATERIAL:					
1. Steel	3. Stainless Steel	5. Fiberglass	<b>7. PVC</b>	9. ABS	11. Other (specify)
2. Brass	4. Galvanized	6. Concrete Tile	8. RMP (SR)	10. Asbestos-Cement	12. None used (open hole)
SCREEN OR PERFORATION OPENINGS ARE:					
1. Continuous slot	3. Mill slot	5. Gauzed wrapped	7. Torch cut	9. Drilled holes	11. None ( open hole)
2. Louvered shutter	4. Key punched	6. Wire wrapped	<b>8. Saw cut</b>	10. Other (specify)	
SCREEN - PERFORATION INTERVAL	From <b>35</b> ft. to <b>80</b> ft.,	From _____ ft. to _____ ft.,	From _____ ft. to _____ ft.,	From _____ ft. to _____ ft.,	From _____ ft. to _____ ft.,
GRAVEL PACK INTERVALS:	From <b>24</b> ft. to <b>80</b> ft.,	From _____ ft. to _____ ft.,	From _____ ft. to _____ ft.,	From _____ ft. to _____ ft.,	From _____ ft. to _____ ft.,

6 GROUT MATERIALS:		1. Neat cement	2. Cement Grout	3. Bentonite	Other <b>bentonite hole plug</b>
Grout Intervals: From <b>4</b> ft. to <b>24</b> ft.,	From _____ ft. to _____ ft.,	From _____ ft. to _____ ft.,	From _____ ft. to _____ ft.,	From _____ ft. to _____ ft.,	From _____ ft. to _____ ft.,
What is the nearest source of possible contamination:					
1. Septic tank	4. Lateral lines	7. Pit privy	10. Livestock pens	13. Insecticide storage	15. Oil well/Gas well
2. Sewer lines	5. Cess Pool	8. Sewage lagoon	11. Fuel storage	14. Abandon water well	16. Other (specify below)
<b>3. Watertight sewer line</b>	6. Seepage pit	9. Feed yard	12. Fertilizer storage		
Direction from well? <b>South</b>					How many feet? <b>10 ft. plus</b>

From	To	LITHOLOGIC LOG	From	To	LITHOLOGIC LOG
0	3	topsoil			
3	25	clay			
25	30	fine sand			
30	39	medium sand			
39	80	grey shale			

7 Contractor's or Landowner's Certification: This water well was 1. <b>constructed</b> 2. reconstructed or 3. plugged under my jurisdiction and was completed on (mo/day/year) <b>7/13/16</b> and this record is true to the best of my knowledge and belief.	
Kansas Water Well Contractor's License No. <b>236</b>	This water well record was completed on (mo/day/year) <b>7/15/16</b>
under the business name of <b>Harp Well and Pump Service</b>	by (signature) <b>Todd S. Harp</b>