

WATER WELL RECORD Form WWC-5


Division of Water Resources App. No.

Well ID

Original Record Correction Change in Well Use

1 LOCATION OF WATER WELL: County: SEDGWICK Fraction SW 1/4 SE 1/4 SE 1/4 NW 1/4 Section Number 26 Township Number T 27 S Range Number R 2 E W

2 WELL OWNER: Last Name: O'NEAL First: GERALD Street or Rural Address where well is located (if unknown, distance and direction from nearest town or intersection): If at owner's address, check here: Business: Address: 14505 W MCCORMICK CIR City: WICHITA State: KS ZIP: 67235

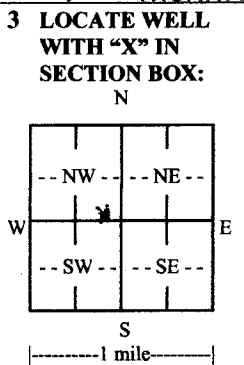

3 LOCATE WELL WITH 'X' IN SECTION BOX: N W E S 1 mile 4 DEPTH OF COMPLETED WELL: 120 ft. Depth(s) Groundwater Encountered: 1) 23 ft. 2) ft. 3) ft. or 4) Dry Well WELL'S STATIC WATER LEVEL: 20 ft. below land surface, measured on (mo-day-yr) 10/27/2016 Pump test data: Well water was after hours pumping gpm Well water was after hours pumping gpm Estimated Yield: 20 gpm Bore Hole Diameter: 10.5 in. to 120 ft. and in. to ft.

5 Latitude: (decimal degrees) Longitude: (decimal degrees) Horizontal Datum: WGS 84 NAD 83 NAD 27 Source for Latitude/Longitude: GPS (unit make/model: (WAAS enabled? Yes No) Land Survey Topographic Map Online Mapper:

6 Elevation: ft. Ground Level TOC Source: Land Survey GPS Topographic Map Other

7 WELL WATER TO BE USED AS: 1. Domestic: Household Lawn & Garden Livestock Irrigation Feedlot Industrial 2. Public Water Supply: well ID 3. Dewatering: how many wells? 4. Aquifer Recharge: well ID 5. Monitoring: well ID 6. Environmental Remediation: well ID Air Sparge Soil Vapor Extraction Recovery Injection 7. Oil Field Water Supply: lease 8. Test Hole: well ID Cased Uncased Geotechnical 9. Geothermal: how many bores? a) Closed Loop Horizontal Vertical b) Open Loop Surface Discharge Inj. of Water 10. Other (specify):

Was a chemical/bacteriological sample submitted to KDHE? Yes No If yes, date sample was submitted: Water well disinfected? Yes No

8 TYPE OF CASING USED: Steel PVC Other CASING JOINTS: Glued Clamped Welded Threaded Casing diameter 5 in. to 120 ft., Diameter in. to ft., Diameter in. to ft. Casing height above land surface 12 in. Weight lbs./ft. Wall thickness or gauge No. SDR-26

TYPE OF SCREEN OR PERFORATION MATERIAL: Steel Stainless Steel Fiberglass PVC Other (Specify) Brass Galvanized Steel Concrete tile None used (open hole)

SCREEN OR PERFORATION OPENINGS ARE: Continuous Slot Mill Slot Gauze Wrapped Torch Cut Drilled Holes Other (Specify) Louvered Shutter Key Punched Wire Wrapped Saw Cut None (Open Hole)

SCREEN-PERFORATED INTERVALS: From 60 ft. to 120 ft., From ft. to ft., From ft. to ft. GRAVEL PACK INTERVALS: From 23 ft. to 120 ft., From ft. to ft., From ft. to ft.

9 GROUT MATERIAL: Neat cement Cement grout Bentonite Other Grout Intervals: From 3 ft. to 23 ft., From ft. to ft., From ft. to ft.

Nearest source of possible contamination: Septic Tank Lateral Lines Pit Privy Livestock Pens Insecticide Storage Sewer Lines Cess Pool Sewage Lagoon Fuel Storage Abandoned Water Well Watertight Sewer Lines Seepage Pit Feedyard Fertilizer Storage Oil Well/Gas Well Other (Specify) Direction from well? EAST Distance from well? 75+ ft.

Table with 6 columns: FROM, TO, LITHOLOGIC LOG, FROM, TO, LITHO. LOG (cont.) or PLUGGING INTERVALS. Rows include TOP SOIL, CLAY, FINE SAND, MED SAND, CLAY, MED/FINE SAND, SHALE.

11 CONTRACTOR'S OR LANDOWNER'S CERTIFICATION: This water well was constructed, reconstructed, or plugged under my jurisdiction and was completed on (mo-day-year) 10/27/2016 and this record is true to the best of my knowledge and belief. Kansas Water Well Contractor's License No. 884. This Water Well Record was completed on (mo-day-year) 11/01/2016 under the business name of WENINGER DRILLING, LLC Signature

Mail 1 white copy along with a fee of \$5.00 for each constructed well to: Kansas Department of Health and Environment, Bureau of Water, GWTS Section, 1000 SW Jackson St., Suite 420, Topeka, Kansas 66612-1367. Mail one to Water Well Owner and retain one for your records. Telephone 785-296-5524.