


WATER WELL RECORD Form WWC-5 KSA 82a-1212

1 LOCATION OF WATER WELL: Sedgwick	FRACTION NW 1/4 SW 1/4 NW 1/4	SECTION NUMBER 13	TOWNSHIP NUMBER T 27 S	RANGE NUMBER R 2W E/W
--	---	-----------------------------	----------------------------------	---------------------------------

Distance and direction from nearest town or city street address of well if located within city?

1105 N. Forestview Wichita, Kansas

2 WATER WELL OWNER: KLAYSMEYER CONSTRUCTION	Board of Agriculture, Division of Water Resource
RR#,ST. ADDRESS,BOX #: 10008 W. York	Application Number:
CITY, STATE: Wichita, Kansas	ZIP CODE:

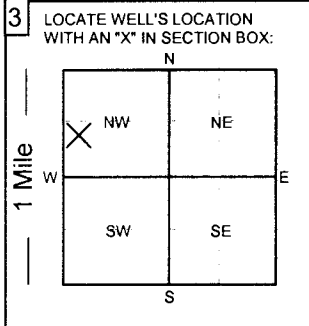

4 DEPTH OF COMPLETED WELL: 82 ft.	ELEVATION:
Depth of groundwater Encountered:	ft.
WELL'S STATIC WATER LEVEL 35 FT. BELOW LAND SURFACE MEASURED ON 10/26/16	mo/day/yr:
Pump test data: Well water was	ft. after
Est. Yield: gpm	hours of pumping @
Bore Hole Diameter 12 in. to 82 ft. and	in. to
WELL WATER TO BE USED AS:	
1. Domestic	3. Feedlot
5. Public water supply	<u>7. Lawn and garden only</u>
2. Irrigation	4. Industrial
6. Oil field water supply	8. Air conditioning
9. Dewatering	11. Injection well
10. Monitoring well	12. Other (Specify below)
Was a chemical/bacteriological sample submitted to Department?	YES <input checked="" type="checkbox"/> NO <input checked="" type="checkbox"/>
Was Water Well Disinfected?	<u>YES</u> NO

5 TYPE OF CASING USED:	1. Steel	3. RPM (SR)	5. Wrought Iron	7. Fiberglass	9. Other (Specify below)	CASING JOINTS:	<u>Glued</u>	Threaded
	<u>2. PVC</u>	4. ABS	6. Asbestos-Cement	8. Concrete tile	SDR-26		Welded	Clamped
Blank casing diameter	5 in.	to	62 ft.,	Dia.	in.	to	ft.,	Dia.
Casing height above land surface:	12 in.,	Weight:	2.35 lbs. / ft.	Wall thickness or gauge No.	.214			
TYPE OF SCREEN OR PERFORATION MATERIAL:								
1. Steel	3. Stainless Steel	5. Fiberglass	<u>7. PVC</u>	9. ABS	11. Other (specify)			
2. Brass	4. Galvanized	6. Concrete Tile	8. RMP (SR)	10. Asbestos-Cement	12. None used (open hole)			
SCREEN OR PERFORATION OPENINGS ARE:								
1. Continuous slot	3. Mill slot	5. Gauzed wrapped	7. Torch cut	9. Drilled holes	11. None (open hole)			
2. Louvered shutter	4. Key punched	6. Wire wrapped	<u>8. Saw cut</u>	10. Other (specify)				
SCREEN - PERFORATION INTERVAL	From	62 ft.	to	82 ft.,	From	ft.	to	ft.
GRAVEL PACK INTERVALS:	From	24 ft.	to	82 ft.,	From	ft.	to	ft.

6 GROUT MATERIALS:	1. Neat cement	2. Cement Grout	3. Bentonite	Other bentonite hole plug
Grout Intervals:	From 4 ft.	to 24 ft.,	From	ft. to
What is the nearest source of possible contamination:				
1. Septic tank	4. Lateral lines	7. Pit privy	10. Livestock pens	13. Insecticide storage
2. Sewer lines	5. Cess Pool	8. Sewage lagoon	11. Fuel storage	14. Abandon water well
<u>3. Watertight sewer line</u>	6. Seepage pit	9. Feed yard	12. Fertilizer storage	15. Oil well/Gas well
Direction from well?	North	How many feet?	10 ft. plus	

From	To	LITHOLOGIC LOG	From	To	LITHOLOGIC LOG
0	3	topsoil			
3	30	clay			
30	50	fine sand			
50	65	clay			
65	82	medium sand			

7 Contractor's or Landowner's Certification: This water well was 1. constructed 2. reconstructed or 3. plugged under my jurisdiction and was completed on (mo/day/year) **10/26/2016** and this record is true to the best of my knowledge and belief.

Kansas Water Well Contractor's License No. **236** This water well record was completed on (mo/day/year) **10/31/2016**

under the business name of **Harp Well and Pump Service** by (signature) **Todd S. Harp**