


WATER WELL RECORD Form WWC-5 KSA 82a-1212

1 LOCATION OF WATER WELL: Sedgwick FRACTION SE 1/4 SE 1/4 NE 1/4 SECTION NUMBER 22 TOWNSHIP NUMBER T 27 S RANGE NUMBER R 2W E/W

Distance and direction from nearest town or city street address of well if located within city? 15255 W. Talopa Goddard, Kansas

2 WATER WELL OWNER: NIES CONSTRUCTION RR# ST. ADDRESS, BOX #: 10333 E 21st N. #303 CITY, STATE: Wichita, Kansas ZIP CODE: 67206 Board of Agriculture, Division of Water Resource Application Number:

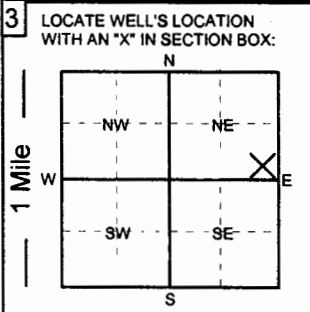

4 DEPTH OF COMPLETED WELL: 65 ft. ELEVATION: Depth of groundwater Encountered: WELL'S STATIC WATER LEVEL 25 FT. BELOW LAND SURFACE MEASURED ON mo/day/yr: 2/26/19 Pump test data: Well water was ft. after hours of pumping @ gpm Est. Yield: gpm Well water was ft. after hours of pumping @ gpm Bore Hole Diameter 12 in. to 65 ft. and in. to ft. WELL WATER TO BE USED AS: 1. Domestic 3. Feedlot 5. Public water supply 7. Lawn and garden only 9. Dewatering 11. Injection well 12. Other (Specify below) 2. Irrigation 4. Industrial 6. Oil field water supply 8. Air conditioning 10. Monitoring well Was a chemical/bacteriological sample submitted to Department? YES NO ; if yes, what mo/day/yr was sample submitted Was Water Well Disinfected? YES NO

5 TYPE OF CASING USED: 1. Steel 3. RPM (SR) 5. Wrought Iron 7. Fiberglass 9. Other (Specify below) CASING JOINTS: Glued Threaded 2. PVC 4. ABS 6. Asbestos-Cement 8. Concrete tile SDR-26 Welded Clamped Blank casing diameter 5 in. to 24 ft., Dia. in. to ft., Dia. in. to ft. Casing height above land surface: 12 in., Weight: 2.35 lbs. / ft. Wall thickness or gauge No. .214 TYPE OF SCREEN OR PERFORATION MATERIAL: 1. Steel 3. Stainless Steel 5. Fiberglass 7. PVC 9. ABS 11. Other (specify) 2. Brass 4. Galvanized 6. Concrete Tile 8. RMP (SR) 10. Asbestos-Cement 12. None used (open hole) SCREEN OR PERFORATION OPENINGS ARE: 1. Continuous slot 3. Mill slot 5. Gauzed wrapped 7. Torch cut 9. Drilled holes 11. None (open hole) 2. Louvered shutter 4. Key punched 6. Wire wrapped 8. Saw cut 10. Other (specify) SCREEN - PERFORATION INTERVAL From 24 ft. to 65 ft., From ft. to ft., From ft. to ft. GRAVEL PACK INTERVALS: From 24 ft. to 65 ft., From ft. to ft., From ft. to ft.

6 GROUT MATERIALS: 1. Neat cement 2. Cement Grout 3. Bentonite Other bentonite hole plug Grout intervals: From ft. to ft., From 4 ft. to 24 ft., From ft. to ft. What is the nearest source of possible contamination: 1. Septic tank 4. Lateral lines 7. Pit privy 10. Livestock pens 13. Insecticide storage 15. Oil well/Gas well 2. Sewer lines 5. Cess Pool 8. Sewage lagoon 11. Fuel storage 14. Abandon water well 16. Other (specify below) 3. Watertight sewer line 6. Seepage pit 9. Feed yard 12. Fertilizer storage Direction from well? South How many feet? 100 ft. plus

LITHOLOGIC LOG			LITHOLOGIC LOG		
From	To		From	To	
0	3	topsoil			
3	22	clay			
22	30	fine sand			
30	65	grey shale			

7 Contractor's or Landowner's Certification: This water well was 1. constructed 2. reconstructed or 3. plugged under my jurisdiction and was completed on (mo/day/year) 2/26/19 and this record is true to the best of my knowledge and belief. Kansas Water Well Contractor's License No. 236 This water well record was completed on (mo/day/year) 2/28/19 under the business name of Harp Well and Pump Service by (signature) Todd S. Harp