


WATER WELL RECORD Form WWC-5 KSA 82a-1212

1 LOCATION OF WATER WELL: <b>Sedgwick</b>	FRACTION <b>SW 1/4 NE 1/4 SW 1/4</b>	SECTION NUMBER <b>28</b>	TOWNSHIP NUMBER <b>T 27 S</b>	RANGE NUMBER <b>R 2W E/W</b>
--	---	-----------------------------	----------------------------------	---------------------------------

Distance and direction from nearest town or city street address of well if located within city?

**946 N. St Andrews Goddard, Kansas**

2 WATER WELL OWNER: <b>KLAUSMEYER CONSTRUCTION</b>	Board of Agriculture, Division of Water Resource		
RR#, ST. ADDRESS, BOX #: <b>10008 W. York</b>	CITY, STATE: <b>Wichita, Kansas</b>	ZIP CODE:	Application Number:

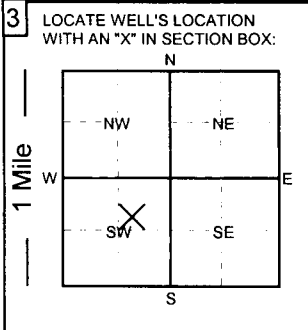

4 DEPTH OF COMPLETED WELL: <b>100</b> ft.	ELEVATION:
Depth of groundwater Encountered:	ft.
WELL'S STATIC WATER LEVEL <b>25</b> FT. BELOW LAND SURFACE MEASURED ON <b>11/19/19</b>	mo/day/yr.
Pump test data:	ft. after hours of pumping @ gpm
Est. Yield: gpm	Well water was ft. after hours of pumping @ gpm
Bore Hole Diameter <b>12</b> in. to <b>100</b> ft. and in. to ft.	
WELL WATER TO BE USED AS:	
1. Domestic 3. Feedlot 5. Public water supply <b>7. Lawn and garden only</b> 9. Dewatering 11. Injection well	12. Other (Specify below)
2. Irrigation 4. Industrial 6. Oil field water supply 8. Air conditioning 10. Monitoring well	
Was a chemical/bacteriological sample submitted to Department? <b>YES</b> <b>NO</b> ; If yes, what mo/day/yr was sample submitted	Was Water Well Disinfected? <b>YES</b> <b>NO</b>

5 TYPE OF CASING USED:				5. Wrought Iron 7. Fiberglass 9. Other (Specify below)		CASING JOINTS: <b>Glued</b> Threaded	
1. Steel 3. RPM (SR)				6. Asbestos-Cement 8. Concrete tile		Welded Clamped	
<b>2. PVC</b> 4. ABS				SDR-26			
Blank casing diameter <b>5</b> in. to <b>32</b> ft., Dia. in. to ft., Dia. in. to ft.		Casing height above land surface: <b>12</b> in., Weight: <b>2.35</b> lbs. / ft.		Wall thickness or gauge No. <b>.214</b>			
TYPE OF SCREEN OR PERFORATION MATERIAL:							
1. Steel 3. Stainless Steel 5. Fiberglass <b>7. PVC</b> 9. ABS 11. Other (specify)		2. Brass 4. Galvanized 6. Concrete Tile 8. RMP (SR) 10. Asbestos-Cement 12. None used (open hole)					
SCREEN OR PERFORATION OPENINGS ARE:							
1. Continuous slot 3. Mill slot 5. Gauzed wrapped 7. Torch cut 9. Drilled holes 11. None (open hole)		2. Louvered shutter 4. Key punched 6. Wire wrapped <b>8. Saw cut</b> 10. Other (specify)					
SCREEN - PERFORATION INTERVAL		From <b>32</b> ft. to <b>100</b> ft.,		From ft. to ft.		From ft. to ft.	
GRAVEL PACK INTERVALS:		From <b>24</b> ft. to <b>100</b> ft.,		From ft. to ft.		From ft. to ft.	

6 GROUT MATERIALS:				1. Neat cement 2. Cement Grout 3. Bentonite Other <b>bentonite hole plug</b>	
Grout intervals: From ft. to ft.,		From ft. to ft.,		From <b>4</b> ft. to <b>24</b> ft.	
What is the nearest source of possible contamination:					
1. Septic tank 4. Lateral lines 7. Pit privy 10. Livestock pens 13. Insecticide storage 15. Oil well/Gas well		2. Sewer lines 5. Cess Pool 8. Sewage lagoon 11. Fuel storage 14. Abandon water well 16. Other (specify below)			
<b>3. Watertight sewer line</b> 6. Seepage pit 9. Feed yard 12. Fertilizer storage		Direction from well? <b>East</b> How many feet? <b>10 ft. plus</b>			

From	To	LITHOLOGIC LOG	From	To	LITHOLOGIC LOG
0	3	topsoil			
3	22	clay			
22	37	fine sand			
37	100	grey shale			

7 Contractor's or Landowner's Certification: This water well was 1. <b>constructed</b> 2. reconstructed or 3. plugged under my jurisdiction and was completed on (mo/day/year) <b>11/19/19</b> and this record is true to the best of my knowledge and belief.			
Kansas Water Well Contractor's License No. <b>236</b>		This water well record was completed on (mo/day/year) <b>11/21/19</b>	
under the business name of <b>Harp Well and Pump Service</b>		by (signature) <b>Todd S. Harp</b>	