


WATER WELL RECORD Form WWC-5 KSA 82a-1212

1 LOCATION OF WATER WELL: Sedgwick	FRACTION NE 1/4 SE 1/4 SE 1/4	SECTION NUMBER 22	TOWNSHIP NUMBER T 27 S	RANGE NUMBER R 2W E/W
---	---	-----------------------------	----------------------------------	---------------------------------

Distance and direction from nearest town or city street address of well if located within city?
182 Ciderbluff Wichita, Kansas

2 WATER WELL OWNER: SHARP HOMES	Board of Agriculture, Division of Water Resource
RR#, ST. ADDRESS, BOX #: 2131 N. Collective Ste #A	Application Number:
CITY, STATE: Wichita, Kansas	ZIP CODE: 67206

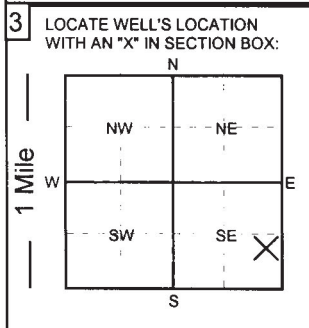

4 DEPTH OF COMPLETED WELL: 116 ft.	ELEVATION:
Depth of groundwater Encountered:	ft.
WELL'S STATIC WATER LEVEL 30 FT. BELOW LAND SURFACE MEASURED ON 6/11/20	
Pump test data:	Well water was ft. after hours of pumping @ gpm
Est. Yield: gpm	Well water was ft. after hours of pumping @ gpm
Bore Hole Diameter 12 in.	to 116 ft. and in. to ft.
WELL WATER TO BE USED AS:	
1. Domestic	3. Feedlot
5. Public water supply	<u>7. Lawn and garden only</u>
9. Dewatering	11. Injection well
2. Irrigation	4. Industrial
6. Oil field water supply	8. Air conditioning
10. Monitoring well	12. Other (Specify below)
Was a chemical/bacteriological sample submitted to Department? YES	<u>NO</u> ; If yes, what mo/day/yr was sample submitted
Was Water Well Disinfected? <u>YES</u>	NO

5 TYPE OF CASING USED:	5. Wrought Iron	7. Fiberglass	9. Other (Specify below)	CASING JOINTS:	<u>Glued</u>	Threaded
1. Steel	3. RPM (SR)				Welded	Clamped
<u>2. PVC</u>	4. ABS	6. Asbestos-Cement	8. Concrete tile	SDR-26		
Blank casing diameter 5 in.	to 40 ft., Dia. in.	to ft., Dia. in.	to ft., Dia. in.	to ft., Dia. in.	to ft., Dia. in.	to ft., Dia. in.
Casing height above land surface: 12 in.,	Weight: 2.35 lbs. / ft.	Wall thickness or gauge No. .214				
TYPE OF SCREEN OR PERFORATION MATERIAL:						
1. Steel	3. Stainless Steel	5. Fiberglass	<u>7. PVC</u>	9. ABS	11. Other (specify)	
2. Brass	4. Galvanized	6. Concrete Tile	8. RMP (SR)	10. Asbestos-Cement	12. None used (open hole)	
SCREEN OR PERFORATION OPENINGS ARE:						
1. Continuous slot	3. Mill slot	5. Gauzed wrapped	7. Torch cut	9. Drilled holes	11. None (open hole)	
2. Louvered shutter	4. Key punched	6. Wire wrapped	<u>8. Saw cut</u>	10. Other (specify)		
SCREEN - PERFORATION INTERVAL	From 40 ft. to 116 ft.,	From ft. to ft.,	From ft. to ft.,	From ft. to ft.,	From ft. to ft.,	From ft. to ft.,
GRAVEL PACK INTERVALS:	From 24 ft. to 116 ft.,	From ft. to ft.,	From ft. to ft.,	From ft. to ft.,	From ft. to ft.,	From ft. to ft.,

6 GROUT MATERIALS:	1. Neat cement	2. Cement Grout	3. Bentonite	Other bentonite hole plug
Grout Intervals: From ft. to ft.,	From ft. to ft.,	From ft. to ft.,	From ft. to ft.,	From 4 ft. to 24 ft.
What is the nearest source of possible contamination:				
1. Septic tank	4. Lateral lines	7. Pit privy	10. Livestock pens	13. Insecticide storage
2. Sewer lines	5. Cess Pool	8. Sewage lagoon	11. Fuel storage	14. Abandon water well
<u>3. Watertight sewer line</u>	6. Seepage pit	9. Feed yard	12. Fertilizer storage	15. Oil well/Gas well
Direction from well? West				16. Other (specify below)
				How many feet? 10 ft. plus

From	To	LITHOLOGIC LOG	From	To	LITHOLOGIC LOG
0	3	topsoil			
3	30	clay			
30	40	fine sand			
40	116	grey shale			

7 Contractor's or Landowner's Certification: This water well was 1. <u>constructed</u> 2. reconstructed or 3. plugged under my jurisdiction and was completed on (mo/day/year) 6/11/2020 and this record is true to the best of my knowledge and belief.
Kansas Water Well Contractor's License No. 236 This water well record was completed on (mo/day/year) 6/11/2020
under the business name of Harp Well and Pump Service by (signature) Todd S. Harp