


WATER WELL RECORD Form WWC-5 KSA 82a-1212

1 LOCATION OF WATER WELL: Sedgwick	FRACTION NE 1/4 NE 1/4 SW 1/4	SECTION NUMBER 36	TOWNSHIP NUMBER T 27 S	RANGE NUMBER R 2W E/W
---	---	-----------------------------	----------------------------------	---------------------------------

Distance and direction from nearest town or city street address of well if located within city?
12854 W. Jewell Wichita, Kansas

2 WATER WELL OWNER: RR#,ST. ADDRESS,BOX #: CITY, STATE:	KLAUSMEYER ,CONSTRUCTION 10008 W. York Wichita, Kansas	Board of Agriculture, Division of Water Resource Application Number: ZIP CODE: 67215
--	---	---

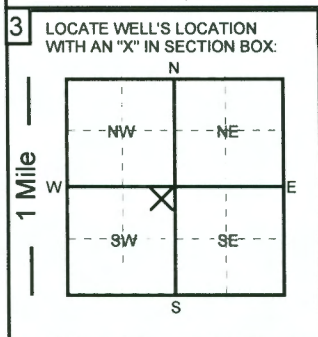

4 DEPTH OF COMPLETED WELL: 85 ft.	ELEVATION: _____ ft.	
Depth of groundwater Encountered: _____ ft.		
WELL'S STATIC WATER LEVEL 25 FT. BELOW LAND SURFACE MEASURED ON 1/20/21	Pump test data: Well water was _____ ft. after _____ hours of pumping @ _____ gpm	
Est. Yield: _____ gpm	Well water was _____ ft. after _____ hours of pumping @ _____ gpm	
Bore Hole Diameter 12 in.	to 85 ft. and _____ in. to _____ ft.	
WELL WATER TO BE USED AS:		
1. Domestic	3. Feedlot	5. Public water supply 7. Lawn and garden only
2. Irrigation	4. Industrial	6. Oil field water supply
8. Air conditioning		
9. Dewatering		
11. Injection well		
12. Other (Specify below)		
10. Monitoring well		
Was a chemical/bacteriological sample submitted to Department? YES NO ; If yes, what mo/day/yr was sample submitted		
Was Water Well Disinfected? YES NO		

5 TYPE OF CASING USED:	1. Steel		3. RPM (SR)		5. Wrought Iron		7. Fiberglass		9. Other (Specify below)		CASING JOINTS: Glued Threaded	
	2. PVC		4. ABS		6. Asbestos-Cement		8. Concrete tile		SDR-26		Welded Clamped	
Blank casing diameter 5 in.			to 40 ft., Dia. _____ in.			to _____ ft., Dia. _____ in.			to _____ ft.			
Casing height above land surface: 12 in.,			Weight: 2.35 lbs. / ft.			Wall thickness or gauge No. 214						
TYPE OF SCREEN OR PERFORATION MATERIAL:												
1. Steel		3. Stainless Steel		5. Fiberglass		7. PVC		9. ABS		11. Other (specify)		
2. Brass		4. Galvanized		6. Concrete Tile		8. RMP (SR)		10. Asbestos-Cement		12. None used (open hole)		
SCREEN OR PERFORATION OPENINGS ARE:												
1. Continuous slot		3. Mill slot		5. Gauzed wrapped		7. Torch cut		9. Drilled holes		11. None (open hole)		
2. Louvered shutter		4. Key punched		6. Wire wrapped		8. Saw cut		10. Other (specify)				
SCREEN - PERFORATION INTERVAL			From 40 ft.		to 85 ft.,		From _____ ft.		to _____ ft.			
			From _____ ft.		to _____ ft.,		From _____ ft.		to _____ ft.			
GRAVEL PACK INTERVALS:			From 24 ft.		to 85 ft.,		From _____ ft.		to _____ ft.			
			From _____ ft.		to _____ ft.,		From _____ ft.		to _____ ft.			

6 GROUT MATERIALS:	1. Neat cement		2. Cement Grout		3. Bentonite		Other bentonite hole plug		
Grout intervals: From _____ ft.		to _____ ft.,		From _____ ft.		to _____ ft.,		From 4 ft. to 24 ft.	
What is the nearest source of possible contamination:									
1. 2. Sewer lines		3. Septic tank		4. Lateral lines		5. Cess Pool		6. Watertight sewer line	
7. Pit privy		8. Sewage lagoon		9. Feed yard		10. Livestock pens		11. Fuel storage	
12. Fertilizer storage		13. Insecticide storage		14. Abandon water well		15. Oil well/Gas well		16. Other (specify below)	
Direction from well? North								How many feet? 30 ft. plus	

From	To	LITHOLOGIC LOG	From	To	LITHOLOGIC LOG
0	3	topsoil			
3	20	clay			
20	32	fine sand			
32	85	grey shale			

7 Contractor's or Landowner's Certification: This water well was 1. constructed 2. reconstructed or 3. plugged under my jurisdiction and was completed on (mo/day/year) 1/20/2021 and this record is true to the best of my knowledge and belief.	
Kansas Water Well Contractor's License No. 236	This water well record was completed on (mo/day/year) 1/22/2021
under the business name of Harp Well and Pump Service	by (signature) Todd S. Harp