


WATER WELL RECORD Form WWC-5

Division of Water Resources App. No. [] Well ID []

[X] Original Record [] Correction [] Change in Well

1 LOCATION OF WATER WELL: Use Fraction Section Number Township Number Range Number
County: Sedgwick SE 1/4 SW 1/4 SE 1/4 SE 1/4 36 T 27 S R 2 [] E [X] W

2 WELL OWNER: Last Name: KELLY First: Nicole Street or Rural Address where well is located (if unknown, distance and direction from nearest town or intersection): If at owner's address, check here: [X]
Business: Address: 2318 S. Rogers Lane Address: City: Wichita State: Kansas ZIP: 67235

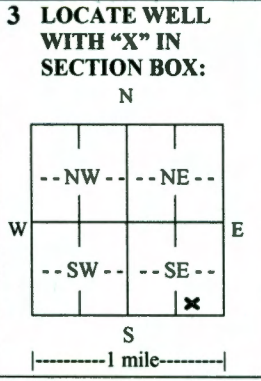

3 LOCATE WELL WITH 'X' IN SECTION BOX: N W E S
4 DEPTH OF COMPLETED WELL: 120 ft. Depth(s) Groundwater Encountered: 1) ... ft. 2) ... ft. 3) ... ft., or 4) [] Dry Well
WELL'S STATIC WATER LEVEL: 30 ft. [X] below land surface, measured on (mo-day-yr) 09/08/21 [] above land surface, measured on (mo-day-yr) ...
Pump test data: Well water was ... ft. after ... hours pumping ... gpm
Well water was ... ft. after ... hours pumping ... gpm
Estimated Yield: ... gpm
Bore Hole Diameter: 12 in. to 120 ft. and ... in. to ... ft.

5 Latitude: 37.65088 (decimal degrees) Longitude: -97.48354 (decimal degrees)
Horizontal Datum: [X] WGS 84 [] NAD 83 [] NAD 27
Source for Latitude/Longitude: [X] GPS (unit make/model: iPhone) (WAAS enabled? [] Yes [] No) [] Land Survey [] Topographic Map [] Online Mapper: ...

6 Elevation: ... ft. [] Ground Level [] TOC Source: [] Land Survey [X] GPS [] Topographic Map [] Other ...

7 WELL WATER TO BE USED AS:
1. Domestic: [] Household [X] Lawn & Garden [] Livestock
2. [] Irrigation
3. [] Feedlot
4. [] Industrial
5. [] Public Water Supply: well ID ...
6. [] Dewatering: how many wells? ...
7. [] Aquifer Recharge: well ID ...
8. [] Monitoring: well ID ...
9. Environmental Remediation: well ID ... [] Air Sparge [] Soil Vapor Extraction [] Recovery [] Injection
10. [] Oil Field Water Supply: lease ...
11. Test Hole: well ID ... [] Cased [] Uncased [] Geotechnical
12. Geothermal: how many bores? ... a) Closed Loop [] Horizontal [] Vertical b) Open Loop [] Surface Discharge [] Inj. of Water
13. [] Other (specify): ...

Was a chemical/bacteriological sample submitted to KDHE? [] Yes [X] No If yes, date sample was submitted: ...
Water well disinfected? [X] Yes [] No

8 TYPE OF CASING USED: [] Steel [X] PVC [] Other CASING JOINTS: [X] Glued [] Clamped [] Welded [] Threaded
Casing diameter .5 in. to 120 ft., Diameter ... in. to ... ft., Diameter ... in. to ... ft.
Casing height above land surface 12 in. Weight 2.35 lbs./ft. Wall thickness or gauge No. SDR-26
TYPE OF SCREEN OR PERFORATION MATERIAL: [] Steel [] Stainless Steel [] Fiberglass [X] PVC [] Other (Specify) ...
[] Brass [] Galvanized Steel [] Concrete tile [] None used (open hole)
SCREEN OR PERFORATION OPENINGS ARE: [] Continuous Slot [] Mill Slot [] Gauze Wrapped [] Torch Cut [] Drilled Holes [] Other (Specify) ...
[] Louvered Shutter [] Key Punched [] Wire Wrapped [X] Saw Cut [] None (Open Hole)
SCREEN-PERFORATED INTERVALS: From 100 ft. to 120 ft., From ... ft. to ... ft., From ... ft. to ... ft.
GRAVEL PACK INTERVALS: From 24 ft. to 120 ft., From ... ft. to ... ft., From ... ft. to ... ft.

9 GROUT MATERIAL: [] Neat cement [] Cement grout [X] Bentonite [] Other
Grout Intervals: From .42 ft. to .24 ft., From ... ft. to ... ft., From ... ft. to ... ft.
Nearest source of possible contamination: [] Septic Tank [] Lateral Lines [] Pit Privy [] Livestock Pens [] Insecticide Storage
[] Sewer Lines [] Cess Pool [] Sewage Lagoon [] Fuel Storage [] Abandoned Water Well
[X] Watertight Sewer Lines [] Seepage Pit [] Feedyard [] Fertilizer Storage [] Oil Well/Gas Well
[] Other (Specify) ...
Direction from well? East Distance from well? 65 ft. plus ... ft.

Table with 6 columns: 10 FROM, TO, LITHOLOGIC LOG, FROM, TO, LITHO. LOG (cont.) or PLUGGING INTERVALS. Rows show soil layers: topsoil (0-3), clay (3-28), fine sand (28-42), clay and fine sand mix (42-90), medium sand (90-120).

Notes:

11 CONTRACTOR'S OR LANDOWNER'S CERTIFICATION: This water well was [X] constructed, [] reconstructed, or [] plugged under my jurisdiction and was completed on (mo-day-year) 09/08/2021 and this record is true to the best of my knowledge and belief.
Kansas Water Well Contractor's License No. 236 This Water Well Record was completed on (mo-day-year) 9/10/2021 under the business name of Harp Well and Pump Service Signature Todd S. Harp