


**WATER WELL RECORD Form WWC-5**

Original Record  Correction  Change in Well Use

Division of Water Resources App. No.          Well ID         

**1 LOCATION OF WATER WELL:** County: **Sedgwick** Fraction **NW 1/4 SW 1/4 NE 1/4 SW 1/4** Section Number **29** Township Number **T 27 S** Range Number **R 2**  E  W

**2 WELL OWNER:** Last Name: **KLAUSMEYER** First: **CONSTRUCTION LLC** Business: **KLAUSMEYER CONSTRUCTION LLC** Address: **10008 W. York** City: **Wichita** State: **Kansas** ZIP: **67215** Street or Rural Address where well is located (if unknown, distance and direction from nearest town or intersection): If at owner's address, check here:  **1068 N. Casado Ct. Goddard, Kansas 67052**

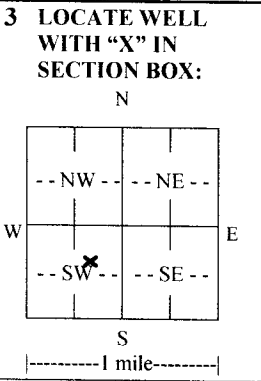

**4 DEPTH OF COMPLETED WELL:** **70** ft. Depth(s) Groundwater Encountered: 1) ..... ft. 2) ..... ft. 3) ..... ft., or 4)  Dry Well WELL'S STATIC WATER LEVEL: **25** ft.  below land surface, measured on (mo-day-yr) **06/27/22**  above land surface, measured on (mo-day-yr) ..... Pump test data: Well water was ..... ft. after ..... hours pumping ..... gpm Well water was ..... ft. after ..... hours pumping ..... gpm Estimated Yield: ..... gpm Bore Hole Diameter: **12** in. to **70** ft. and ..... in. to ..... ft.

**5 Latitude:** **37.66881** ..... (decimal degrees) **Longitude:** **-97.56612** ..... (decimal degrees) Horizontal Datum:  WGS 84  NAD 83  NAD 27 Source for Latitude/Longitude:  GPS (unit make/model: **iPhone** ..... ) (WAAS enabled?  Yes  No)  Land Survey  Topographic Map  Online Mapper: .....

**6 Elevation:** ..... ft.  Ground Level  TOC Source:  Land Survey  GPS  Topographic Map  Other .....

**7 WELL WATER TO BE USED AS:**

1. Domestic: <input type="checkbox"/> Household <input checked="" type="checkbox"/> Lawn & Garden <input type="checkbox"/> Livestock	5. <input type="checkbox"/> Public Water Supply: well ID .....	10. <input type="checkbox"/> Oil Field Water Supply: lease .....
2. <input type="checkbox"/> Irrigation	6. <input type="checkbox"/> Dewatering: how many wells? .....	11. Test Hole: well ID ..... <input type="checkbox"/> Cased <input type="checkbox"/> Uncased <input type="checkbox"/> Geotechnical
3. <input type="checkbox"/> Feedlot	7. <input type="checkbox"/> Aquifer Recharge: well ID .....	12. Geothermal: how many bores? ..... a) Closed Loop <input type="checkbox"/> Horizontal <input type="checkbox"/> Vertical
4. <input type="checkbox"/> Industrial	8. <input type="checkbox"/> Monitoring: well ID .....	b) Open Loop <input type="checkbox"/> Surface Discharge <input type="checkbox"/> Inj. of Water
	9. Environmental Remediation: well ID ..... <input type="checkbox"/> Air Sparge <input type="checkbox"/> Soil Vapor Extraction <input type="checkbox"/> Recovery <input type="checkbox"/> Injection	13. <input type="checkbox"/> Other (specify): .....

**Was a chemical/bacteriological sample submitted to KDHE?**  Yes  No If yes, date sample was submitted: ..... Water well disinfected?  Yes  No

**8 TYPE OF CASING USED:**  Steel  PVC  Other ..... CASING JOINTS:  Glued  Clamped  Welded  Threaded Casing diameter **.5** in. to **70** ft., Diameter ..... in. to ..... ft., Diameter ..... in. to ..... ft. Casing height above land surface **12** in. Weight **2.35** lbs./ft. Wall thickness or gauge No. **SDR-26** TYPE OF SCREEN OR PERFORATION MATERIAL:  Steel  Stainless Steel  Fiberglass  PVC  Other (Specify) .....  Brass  Galvanized Steel  Concrete tile  None used (open hole) SCREEN OR PERFORATION OPENINGS ARE:  Continuous Slot  Mill Slot  Gauze Wrapped  Torch Cut  Drilled Holes  Other (Specify) .....  Louvered Shutter  Key Punched  Wire Wrapped  Saw Cut  None (Open Hole) SCREEN-PERFORATED INTERVALS: From **50** ft. to **70** ft., From ..... ft. to ..... ft., From ..... ft. to ..... ft. GRAVEL PACK INTERVALS: From **24** ft. to **70** ft., From ..... ft. to ..... ft., From ..... ft. to ..... ft.

**9 GROUT MATERIAL:**  Neat cement  Cement grout  Bentonite  Other ..... Grout Intervals: From **.4** ft. to **24** ft., From ..... ft. to ..... ft., From ..... ft. to ..... ft. Nearest source of possible contamination:  Septic Tank  Lateral Lines  Pit Privy  Livestock Pens  Insecticide Storage  Sewer Lines  Cess Pool  Sewage Lagoon  Fuel Storage  Abandoned Water Well  Watertight Sewer Lines  Seepage Pit  Feedyard  Fertilizer Storage  Oil Well/Gas Well  Other (Specify) ..... Direction from well? **North** ..... Distance from well? **45 plus** ..... ft.

10 FROM	TO	LITHOLOGIC LOG	FROM	TO	LITHO. LOG (cont.) or PLUGGING INTERVALS
0	3	topsoil			
3	28	clay			
28	45	fine sand			
45	55	medium sand			
55	68	gray shale			
68	70	limestone			
			Notes:		

**11 CONTRACTOR'S OR LANDOWNER'S CERTIFICATION:** This water well was  constructed,  reconstructed, or  plugged under my jurisdiction and was completed on (mo-day-year) **06/27/2022**, and this record is true to the best of my knowledge and belief. Kansas Water Well Contractor's License No. **236** This Water Well Record was completed on (mo-day-year) **6/29/2022** under the business name of **Harp Well and Pump Service** Signature **Todd S. Harp**