


WATER WELL RECORD Form WWC-5

Original Record Correction Change in Well Use

Division of Water Resources App. No. Well ID

1 LOCATION OF WATER WELL: County: Sedgwick Fraction SW 1/4 SE 1/4 SW 1/4 SE 1/4 Section Number 20 Township Number T 27 S Range Number R 2 E W

2 WELL OWNER: Last Name: MARQUEZ First: Amadur Street or Rural Address where well is located: 1513 E. Elk Ridge Ave. Goddard, Kansas 67052

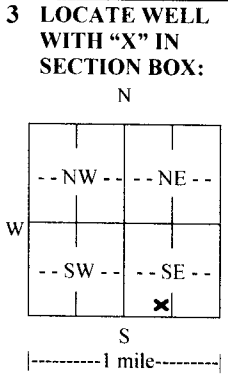

3 LOCATE WELL WITH 'X' IN SECTION BOX: 4 DEPTH OF COMPLETED WELL: 120 ft. WELL'S STATIC WATER LEVEL: 20 ft.

5 Latitude: 37.67900 Longitude: -97.55932 Source for Latitude/Longitude: GPS

6 Elevation: Source: GPS

7 WELL WATER TO BE USED AS: 1. Domestic 2. Irrigation 3. Feedlot 4. Industrial 5. Public Water Supply 6. Dewatering 7. Aquifer Recharge 8. Monitoring 9. Environmental Remediation 10. Oil Field Water Supply 11. Test Hole 12. Geothermal 13. Other

Was a chemical/bacteriological sample submitted to KDHE? No Water well disinfected? Yes

8 TYPE OF CASING USED: Steel PVC Other CASING JOINTS: Glued Clamped Welded Threaded Casing diameter: 5 in. to 120 ft. Diameter: 2.35 lbs./ft. Wall thickness or gauge No. SDR-26

TYPE OF SCREEN OR PERFORATION MATERIAL: PVC SCREEN OR PERFORATION OPENINGS ARE: Saw Cut SCREEN-PERFORATED INTERVALS: 30 ft. to 120 ft. GRAVEL PACK INTERVALS: 24 ft. to 120 ft.

9 GROUT MATERIAL: Bentonite Grout Intervals: .4 ft. to .24 ft. Nearest source of possible contamination: Watertight Sewer Lines Direction from well? South Distance from well? 50 ft. plus

Table with columns: 10 FROM, TO, LITHOLOGIC LOG, FROM, TO, LITHO. LOG (cont.) or PLUGGING INTERVALS. Rows: 0-3 topsoil, 3-26 clay, 26-33 fine sand, 33-120 gray shale.

11 CONTRACTOR'S OR LANDOWNER'S CERTIFICATION: This water well was constructed, reconstructed, or plugged under my jurisdiction and was completed on (mo-day-year) 07/08/2022. Kansas Water Well Contractor's License No. 236 This Water Well Record was completed on (mo-day-year) 7/11/2022 under the business name of Harp Well and Pump Service Signature Todd S. Harp

Mail 1 white copy along with a fee of \$5.00 for each constructed well to: Kansas Department of Health and Environment, Bureau of Water, GWTS Section, 1000 SW Jackson St., Suite 420, Topeka, Kansas 66612-1367. Mail one to Water Well Owner and retain one for your records. Telephone 785-296-5524.