USE TYPEWRITER OR BALL POINT PEN–PRESS FIRMLY, PRINT CLEARLY.

T R EW sec 1/4 1/4 1/4 No.

WATER WELL RECORD
KSA 82a-1201-1215

Kansas State Dept. Of Health
(Water Well Contractors)
Forbes-Bldg. 740
Topeka, Kansas 66620

27

1 Location of well:	County	Township name	Fraction	Section number	Town number	Range number
	Sedg.	Attica	SW-SWSE	1	~~[illegible]~~ S	2W.

Distance and direction from nearest town or city: 2301 Cedarcrest Wichita KS

Street address of well location if in city: ~~4204 Cedarcrest Rd. Wichita~~

3 Owner of well: Steve Kelley.

Address: 2611 Newell Wichita KS. 67205.

Locate with "X" in section below: N W E S (X in section, near S) ├—1 Mile—┤

Sketch map:

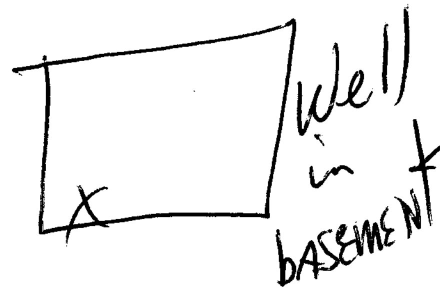

4 Well depth: 80 ft. Date of completion 3/10/77
Well diameter ~~5~~ ~~in.~~ 11"

5 ☐ Cable tool ☒ Rotary ☐ Driven ☐ Dug
☐ Hollow rod ☐ Jetted ☐ Bored ☐ Reverse rotary

6 Use: ☒ Domestic ☐ Public supply ☐ Industry
☐ Irrigation ☐ Air conditioning ☐ Commercial
☐ Test well ☐ ______

7 Casing: Material PVC Height: (above)/below
Threaded ☐ Welded ☒ Surface 12 in.
Diam. Weight 2.21 lbs./160
5 in. to 80 ft. depth Drive shoe? ☐ Yes ☒ No
___ in. to ___ ft. depth

8 Screen:
Manufacturer Pampco MPI
Type PVC Dia. 5in
(Slot)/gauze .116 Length 5ft
Set between 75 ft. and 80 ft.
Fittings:
Gravel pack ☒ Yes ☐ No Size range of material 3/8

9 Static water level:
24 ft. below land surface Date 3/10/77

10 Pumping level below land surfaces:
26 ft. after 1/2 hrs. pumping 20 g.p.m.
___ ft. after ___ hrs. pumping ___ g.p.m.
Estimated maximum yield 50 g.p.m.

11 Water sample submitted:
☐ Yes ☒ No Date ______

12 Well head completion:
☐ Pitless adapter 12 inches above grade

13 Well grouted? ☒ Yes ☐ No
☒ Neat cement ☐ Bentonite ☐ ______
Depth: From 8 ft. to 18 ft.

14 Nearest source of possible contamination:
ft 800 Direction W Type CREEK
Well disinfected upon completion? ☒ Yes ☐ No

15 Pump: ☒ Not installed
Manufacturer's name ______
Model number ______ HP ______ Volts ______
Length of drop pipe ______ ft. capacity ______ g.m.p.
Type:
☐ Submersible ☐ Turbine
☐ Jet ☐ Reciprocating
☐ Certrifugal ☐ Other

2 Type and color of material	From	To
Top soil.	0	6
red clay.	6	22
fine sand	22	35
red clay.	35	36
fine sand.	36	48
clay.	48	49
fine to med. gravel.	49	80

(use a second sheet if needed)

16 Remarks: elevation

Topography:
☒ Hill
☐ Slope
☐ Upland
☐ Volley

17 Water well contractor's certification:
This well was drilled under my jurisdiction and this report is true to the best of my knowledge and belief.
Business name [signature] License No. 318
Address Colwich KS
Signed [signature] Date 3/10/77
Authorized representative

Forward the white, blue and pink copies to the Kansas State Dept. Of Health.

Form WWC-5

677-H