USE TYPEWRITER OR BALL POINT PEN-PRESS FIRMLY, PRINT CLEARLY.

T R EW sec 1/4 1/4 1/4 No.

WATER WELL RECORD
KSA 82a-1201-1215

Kansas State Dept. Of Health
(Water Well Contractors)
Forbes-Bldg. 740
Topeka, Kansas 66620

27

1 Location of well:	County	Township name	Fraction	Section number	Town number	Range number
	Sedg	Union	SWSWSE	1	26 S	2 W

Distance and direction from nearest town or city: 4 miles So. Maize Ks, 1½ West.
Street address of well location if in city:

3 Owner of well: Ray Van Skiver
Address: 2500 N. Curtis Ln Wichita, Ks

Locate with "X" in section below:

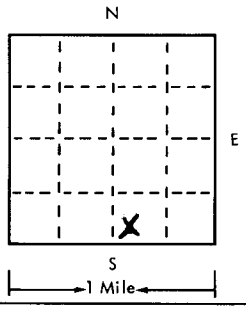

Sketch map:

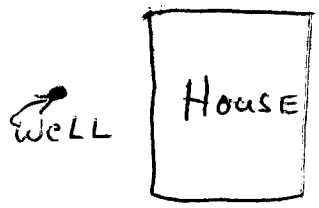

4 Well depth: 65 ft. Date of completion 11/30/75
Well diameter 5 in.

5 ☐ Cable tool ☑ Rotary ☐ Driven ☐ Dug ☐ Hollow rod ☐ Jetted ☐ Bored ☐ Reverse rotary

6 Use: ☑ Domestic ☐ Public supply ☐ Industry ☐ Irrigation ☐ Air conditioning ☐ Commercial ☐ Test well ☐

7 Casing: Material RMP Height: above/below Surface 12 in.
Threaded ☐ Welded ☑ Weight 150 lbs./ft 100
Diam. 5 in. to 65 ft. depth Drive shoe? ☐ Yes ☒ No
___ in. to ___ ft. depth

2

Type and color of material	From	To
Top Sol	0	8
Clay.	8	18
fine Sand & clay.	18	26
fine Sand to course	26	65
(use a second sheet if needed)		

8 Screen:
Manufacturer Sunflower.
Type Plastic Dia. 5 in.
Slot/gauze 18 in Length 10 ft.
Set between 55 ft. and 65 ft.
Fittings:
Gravel pack ☑ Yes ☐ No Size range of material 3/8

9 Static water level: 28 ft. below land surface Date 11/30

10 Pumping level below land surfaces:
30 ft. after 1 hrs. pumping 18 g.p.m.
___ ft. after ___ hrs. pumping ___ g.p.m.
Estimated maximum yield 100 g.p.m.

11 Water sample submitted: ☐ Yes ☑ No Date ___

12 Well head completion:
☑ Pitless adapter 12 inches above grade

13 Well grouted? ☑ Yes ☐ No
☑ Neat cement ☐ Bentonite ☐
Depth: From 3 ft. to 13 ft.

14 Nearest source of possible contamination: Septic
ft. 75 Direction NE Type
Well disinfected upon completion? ☑ Yes ☐ No

15 Pump: ☐ Not installed
Manufacturer's name Valley.
Model number 1807 HP ½ Volts 230
Length of drop pipe 40 ft. capacity 18 g.m.p.
Type:
☑ Submersible ☐ Turbine
☐ Jet ☐ Reciprocating
☐ Certrifugal ☐ Other

16 Remarks: elevation

Topography:
☐ Hill
☐ Slope
☑ Upland
☐ Valley

17 Water well contractor's certification:
This well was drilled under my jurisdiction and this report is true to the best of my knowledge and belief.
Weninger Drly Inc. 318
Business name License No.
Address R#1
Signed Colwich Ks Date 11/30/75
Authorized representative

26 2W 1 SW SW SE

Forward the white, blue and pink copies to the Kansas State Dept. Of Health.

Form WWC-5

677-H