


1 LOCATION OF WATER WELL: Fraction NE 1/4 NW 1/4 SE 1/4 Section Number 1 Township Number T 27 S Range Number R 2 E/W
 County: Sedgwick
 Distance and direction from nearest town or city street address of well if located within city?

See Below -

2 WATER WELL OWNER: Clyde Puckett
 RR#, St. Address, Box #: 2520 Cedarcroft Dr.
 City, State, ZIP Code: Wichita KS 67223

Board of Agriculture, Division of Water Resources
 Application Number:

3 LOCATE WELL'S LOCATION WITH AN "X" IN SECTION BOX:

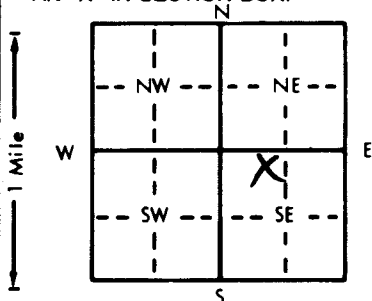

4 DEPTH OF COMPLETED WELL: 65 ft. ELEVATION:

Depth(s) Groundwater Encountered 1. 28 ft. 2. 28 ft. 3. 20 ft.

WELL'S STATIC WATER LEVEL 28 ft. below land surface measured on mo/day/yr 11-3-89

Pump test data: Well water was 28 ft. after 2 hours pumping 20 gpm

Est. Yield 100 gpm: Well water was 28 ft. after 2 hours pumping 20 gpm

Bore Hole Diameter 11 in. to 6.5 ft., and 6.5 in. to 6.5 ft.

WELL WATER TO BE USED AS: 5 Public water supply 8 Air conditioning 11 Injection well

1 Domestic 3 Feedlot 6 Oil field water supply 9 Dewatering 12 Other (Specify below)

2 Irrigation 4 Industrial 7 Lawn and garden only 10 Monitoring well

Was a chemical/bacteriological sample submitted to Department? Yes X No X; If yes, mo/day/yr sample was submitted

Water Well Disinfected? Yes X No X

5 TYPE OF BLANK CASING USED:

- 1 Steel 2 RMP (SR)
 2 PVC 4 ABS

- 5 Wrought iron 8 Concrete tile
 6 Asbestos-Cement 9 Other (specify below)
 7 Fiberglass

CASING JOINTS: Glued X Clamped

Welded

Threaded

Blank casing diameter 5 in. to 5.2 ft., Dia 5.2 in. to 5.2 ft., Dia 5.2 in. to 5.2 ft.

Casing height above land surface 1.2 in., weight 1.59 lbs./ft. Wall thickness or gauge No SOR-26

TYPE OF SCREEN OR PERFORATION MATERIAL:

- 1 Steel 3 Stainless steel
 2 Brass 4 Galvanized steel

- 5 Fiberglass 6 Concrete tile

- 7 PVC 8 RMP (SR)
 9 ABS

- 10 Asbestos-cement

- 11 Other (specify) 12 None used (open hole)

SCREEN OR PERFORATION OPENINGS ARE:

- 1 Continuous slot 3 Mill slot
 2 Louvered shutter 4 Key punched

- 5 Gauzed wrapped

- 8 Saw cut

- 11 None (open hole)

- 6 Wire wrapped

- 9 Drilled holes

- 7 Torch cut 6.5

- 10 Other (specify)

SCREEN-PERFORATED INTERVALS: From 5.2 ft. to 6.5 ft., From 5.2 ft. to 6.5 ft., From 5.2 ft. to 6.5 ft.

GRAVEL PACK INTERVALS: From 2.3 ft. to 6.5 ft., From 2.3 ft. to 6.5 ft., From 2.3 ft. to 6.5 ft.

6 GROUT MATERIAL:

- 1 Neat cement 2 Cement grout

- 3 Bentonite

- 4 Other

Grout Intervals: From 3 ft. to 2.3 ft., From 3 ft. to 2.3 ft., From 3 ft. to 2.3 ft.

What is the nearest source of possible contamination:

- 1 Septic tank 4 Lateral lines
2 Sewer lines 5 Cess pool
 3 Watertight sewer lines 6 Seepage pit

- 7 Pit privy 8 Sewage lagoon
 9 Feedyard

- 10 Livestock pens

- 14 Abandoned water well

- 11 Fuel storage

- 15 Oil well/Gas well

- 12 Fertilizer storage

- 16 Other (specify below)

- 13 Insecticide storage

Direction from well? EAST

How many feet? 100

FROM	TO	LITHOLOGIC LOG	FROM	TO	PLUGGING INTERVALS
0	2	Topsoil			
2	21	clay			
21	34	fine sand			
34	35	clay			
35	65	fine to med sand			

7 CONTRACTOR'S OR LANDOWNER'S CERTIFICATION: This water well was (1) constructed (2) reconstructed, or (3) plugged under my jurisdiction and was completed on (mo/day/year) 11-3-89 and this record is true to the best of my knowledge and belief. Kansas Water Well Contractor's License No. 1318 This Water Well Record was completed on (mo/day/yr) 11-5-89 under the business name of Weninger, Duller by (signature) Weninger