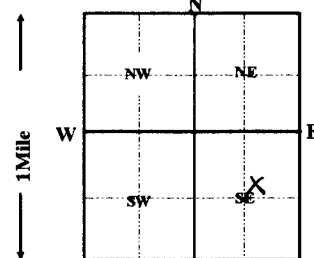


1 LOCATION OF WATER WELL:		FRACTION		Section Number		Township Number		Range Number	
Sedgwick		SW 1/4 NE 1/4 SE 1/4		1		T 27 S		R 2W E/W	
Distance and direction from nearest town or city street address of well if located within city?									
2411 Cedar Downs Wichita, Kansas									
2 WATER WELL OWNER:		MC MANUS, August							
RR#, ST. ADDRESS, BOX #:		2411 Cedar Downs							
CITY, STATE, ZIP CODE:		Wichita, Kansas 67223							
3 LOCATE WELL'S LOCATION WITH AN "X" IN SECTION BOX:		4 DEPTH OF COMPLETED WELL 80 ft. ELEVATION:							
		Depth(s) groundwater Encountered 1 ft. 2 ft. 3 ft.							
		WELL'S STATIC WATER LEVEL 24 FT. BELOW LAND SURFACE MEASURED ON 09/14/1992							
		Pump test data: Well water was ft. after hours pumping gpm							
		Est. Yield gpm: Well water was ft. after hours pumping gpm							
		Bore Hole Diameter 12 in. to 80 ft., and in. to ft.							
		WELL WATER TO BE USED AS: 5 Public water supply 8 Air conditioning 11 Injection well							
		1 Domestic 3 Feedlot 6 Oil field water supply 9 Dewatering 12 Other (Specify below)							
		2 Irrigation 4 Industrial 7 Lawn and garden only 10 Monitoring well							
		Was a chemical/bacteriological sample submitted to Department? Yes No X ; If yes, mo/day/yr sample was submitted							
5 TYPE OF CASING USED:		Water Well Disinfected? Yes X No							
1 Steel 3 RMP (SR)		5 Wrought iron 8 Concrete tile CASING JOINTS: Glued X Clamped							
2 PVC 4 ABS		6 Asbestos-Cement 9 Other (Specify below) Welded							
		7 Fiberglass SDR-26 Threaded							
Blank casing Diameter 5 in. to 60 ft., Dia in. to ft.									
Casing height above land surface 12 in., weight 2.35 lbs. / ft.		Wall thickness or gauge No. .214							
TYPE OF SCREEN OR PERFORATION MATERIAL:		7 PVC 10 Asbestos-cement							
1 Steel 3 Stainless Steel		8 RMP (SR) 11 other (specify)							
2 Brass 4 Galvanized steel		9 ABS 12 None used (open hole)							
SCREEN OR PERFORATION OPENING ARE:		5 Gauzed wrapped 8 Saw cut 11 None (open hole)							
1 Continuous slot 3 Mill slot		6 Wire wrapped 9 Drilled holes							
2 Louvered shutter 4 Key punched		7 Torch cut 10 Other (specify)							
SCREEN-PERFORATION INTERVALS:		from 60 ft. to 80 ft., From ft. to ft.							
GRAVEL PACK INTERVALS:		from 24 ft. to 80 ft., From ft. to ft.							
6 GROUT MATERIAL: 1 Neat cement 2 Cement grout 3 Bentonite 4 Other									
Grout Intervals: From 4 ft. to 24 ft., From ft. to ft.									
What is the nearest source of possible contamination:		10 Livestock pens 14 Abandon water well							
1 Septic tank 4 Lateral lines 7 Pit privy		11 Fuel storage 15 Oil well/Gas well							
2 Sewer lines 5 Cess pool 8 Sewage lagoon		12 Fertilizer storage 16 Other (specify below)							
3 Watertight sewer lines 6 Seepage pit 9 Feedyard		13 Insecticide storage None Apparent							
Direction form well?		How many feet?							
FROM	TO	LITHOLOGIC LOG	FROM	TO	PLUGGING INTERVALS				
0	3	topsoil							
3	21	clay							
21	48	fine sand							
48	53	clay							
53	80	medium sand							
7 CONTRACTOR'S OR LANDOWNER'S CERTIFICATION: This water well was (1) constructed, (2) reconstructed, or (3) plugged under my jurisdiction and was completed on (mo/day/year) 09/14/1992 and this record is true to the best of my knowledge and belief. Kansas Water Well Contractor's License No. 236 This Water Well Record was completed on (mo/day/yr) 10/13/92 Under the business name of Harp Well & Pump Service, Inc. by (signature) Jane Frederick									