

1 LOCATION OF WATER WELL: County: <u>Sedgwick</u> Fraction: <u>NW 1/4 SW 1/4 SE 1/4</u> Section Number: <u>1</u> Township Number: <u>T 27 S</u> Range Number: <u>R 2 E</u>

Distance and direction from nearest town or city street address of well if located within city?

2312 Cedar Crest, Wichita KS

2 WATER WELL OWNER:

RR#, St. Address, Box #:

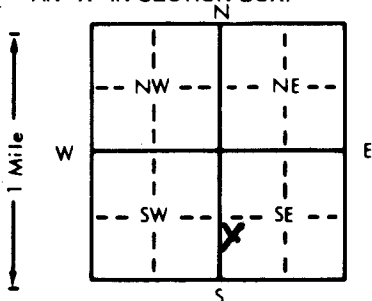
City, State, ZIP Code:

Odell Const.
14126 Valley H. Rd
Wichita KS 67235

Board of Agriculture, Division of Water Resources

Application Number:

3 LOCATE WELL'S LOCATION WITH AN "X" IN SECTION BOX:

4 DEPTH OF COMPLETED WELL: 50 ft. ELEVATION:Depth(s) Groundwater Encountered 1. 28 ft. 2. 28 ft. 3. 28 ft.WELL'S STATIC WATER LEVEL 28 ft. below land surface measured on mo/day/yr 7-14-81Pump test data: Well water was 29 ft. after 1/2 hours pumping 20 gpmEst. Yield 50 gpm: Well water was 29 ft. after 1/2 hours pumping 20 gpmBore Hole Diameter 11 in. to 50 ft. and 50 in. to 50 ft.

WELL WATER TO BE USED AS: 5 Public water supply 8 Air conditioning 11 Injection well

1 Domestic 3 Feedlot 6 Oil field water supply 9 Dewatering 12 Other (Specify below)

2 Irrigation 4 Industrial 7 Lawn and garden only 10 Observation well

Was a chemical/bacteriological sample submitted to Department? Yes X No X; If yes, mo/day/yr sample was submittedWater Well Disinfected? Yes X No X

5 TYPE OF BLANK CASING USED:

1 Steel 3 RMP (SR)

2 PVC 4 ABS

Blank casing diameter 5 in. to 30 ft. Dia 5 in. to 30 ft. Dia 5 in. to 30 ft. Dia 5 in. to 30 ft.Casing height above land surface 12 in. weight 1.59 lbs./ft. Wall thickness or gauge No SPR-26

TYPE OF SCREEN OR PERFORATION MATERIAL:

1 Steel 3 Stainless steel

2 Brass 4 Galvanized steel











SCREEN OR PERFORATION OPENINGS ARE:

1 Continuous slot 3 Mill slot

2 Louvered shutter 4 Key punched

5 Gauzed wrapped

6 Wire wrapped

7 Torch cut

8 Saw cut

9 Drilled holes

10 Other (specify)

11 None (open hole)

12 None used (open hole)

SCREEN-PERFORATED INTERVALS:


6 GROUT MATERIAL:

1 Neat cement 2 Cement grout

3 Bentonite 4 Other


What is the nearest source of possible contamination:

1 Septic tank 4 Lateral lines

2 Sewer lines 5 Cess pool

3 Watertight sewer lines 6 Seepage pit

7 Pit privy 8 Sewage lagoon

9 Feedyard 10 Livestock pens

11 Fuel storage 14 Abandoned water well

12 Fertilizer storage 15 Oil well/Gas well

13 Insecticide storage 16 Other (specify below)

Direction from well?

EASTHow many feet? 557 CONTRACTOR'S OR LANDOWNER'S CERTIFICATION: This water well was (1) constructed, (2) reconstructed, or (3) plugged under my jurisdiction and was completed on (mo/day/year) 7-14-81 and this record is true to the best of my knowledge and belief. KansasWater Well Contractor's License No. 318 This Water Well Record was completed on (mo/day/yr) 7-31-81under the business name of Wenger Pully by (signature) Wenger Pully

INSTRUCTIONS: Use typewriter or ball point pen. PLEASE PRESS FIRMLY and PRINT clearly. Please fill in blanks, underline or circle the correct answers. Send top three copies to Kansas Department of Health and Environment, Division of Environment, Environmental Geology Section, Topeka, KS 66620. Send one to WATER WELL OWNER and retain one for your records.

OFFICE USE ONLY

T

27

R

N

EW

SEC.

1

NW 1/4

SW 1/4

SE 1/4

NE 1/4