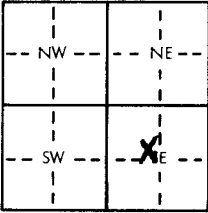
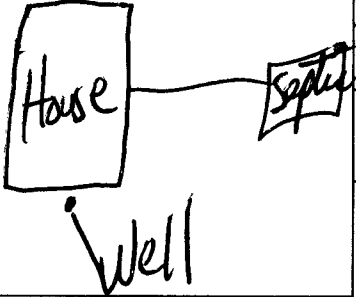


USE TYPEWRITER OR BALL
POINT PEN-PRESS FIRMLY,
PRINT CLEARLY.

WATER WELL RECORD
KSA 82a-1201-1215

Kansas Department of Health and
Environment-Division of Environment
(Water well Contractors)
Topeka, Kansas 66620

1. Location of well:	County <u>Sedgwick</u>	Fraction <u>SE 1/4 NW 1/4 SE 1/4</u>	Section number <u>1</u>	Township number <u>T 27 S</u>	Range number <u>R 2 E</u>
2. Distance and direction from nearest town or city:	3. Owner of well: <u>Odell Const</u>				
Street address of well location if in city:	R.R. or street: <u>14126 Valley Hi Rd.</u>				
<u>2800 Cedarcrest Wichita KS</u>	City, state, zip code: <u>Wichita KS 67235</u>				
4. Locate with "X" in section below:	Sketch map:		6. Bore hole dia. <u>4</u> in. Completion date <u>2/9/79</u> Well depth <u>75</u> ft.		
			7. Cable tool ☒ Rotary ☐ Driven ☐ Dug ☐ Hollow rod ☐ Jetted ☐ Bored ☐ Reverse rotary		
5. Type and color of material	From	To	8. Use: ☒ Domestic ☐ Public supply ☐ Industry ☐ Irrigation ☐ Air conditioning ☐ Stock ☐ Lawn ☐ Oil field water ☐ Other		
<u>top soil</u>	<u>0</u>	<u>3</u>	9. Casing: Material <u>stainless</u> Height: Above or below Threaded ☐ Welded ☒ Surface <u>12</u> in. RMP ☒ PVC ☐ Weight <u>1.50</u> lbs./ft. Dia. <u>5</u> in. to <u>7.5</u> ft. depth Wall Thickness: inches or Dia. <u>5</u> in. to <u>7.5</u> ft. depth gage No. <u>200</u>		
<u>Red clay</u>	<u>3</u>	<u>26</u>	10. Screen: Manufacturer's name <u>Sunflower</u> Type <u>200</u> Dia. <u>5</u> in. Slot/auze <u>1/16</u> Length <u>5</u> ft. Set between <u>68</u> ft. and <u>73</u> ft. Gravel pack <u>yes</u> size range of material <u>3/8</u>		
<u>fine sand</u>	<u>26</u>	<u>48</u>	11. Static water level: <u>30</u> ft. below land surface Date <u>2/9/79</u>		
<u>gray clay</u>	<u>48</u>	<u>54</u>	12. Pumping level below land surfaces: <u>31</u> ft. after <u>1/2</u> hrs. pumping <u>20</u> g.p.m. <u>31</u> ft. after <u>1</u> hrs. pumping <u>20</u> g.p.m. Estimated maximum yield <u>50</u> g.p.m.		
<u>fine sand</u>	<u>54</u>	<u>63</u>	13. Water sample submitted: <u>no</u> mo./day/yr.		
<u>gray clay</u>	<u>63</u>	<u>64</u>	14. Well head completion: ☒ Pitless adapter <u>12</u> inches above grade		
<u>med to coarse gravel</u>	<u>64</u>	<u>75</u>	15. Well grouted? <u>yes</u> With: <u>yes</u> Neat cement ☐ Bentonite ☒ Concrete Depth: From <u>3</u> ft. to <u>13</u> ft.		
			16. Nearest source of possible contamination: ft. <u>5</u> Direction <u>no</u> Type <u>Septic</u> Well disinfected upon completion? ☒ Yes ☐ No		
			17. Pump: <u>not installed</u> Manufacturer's name <u>E.F.W.</u> Model number <u>7BKT</u> HP <u>1/2</u> Volts <u>220</u> Length of drop pipe <u>50</u> ft. capacity <u>10</u> g.p.m. Type: ☒ Submersible ☐ Turbine ☐ Jet ☐ Reciprocating ☐ Centrifugal ☐ Other		
18. Elevation:	19. Remarks:				
Topography: ☐ Hill ☐ Slope ☒ Upland ☐ Valley	<u>Customer to furnish 4x4x4 slab around well at grade per State Regulations</u> <u>Signed X Clinton E Odell</u>				
20. Water well contractor's certification: This well was drilled under my jurisdiction and this report is true to the best of my knowledge and belief. <u>Wmings Miller</u> 318 Business name <u>Churich KS</u> License No. <u>318</u> Address <u>Wichita KS</u> Signed <u>John Miller</u> Date <u>2/9/79</u> Authorized representative					

Forward the white, blue and pink copies to the Department of Health and Environment

Farm WWC-5