

1 LOCATION OF WATER WELL: Fraction NW 1/4 SW 1/4 SE 1/4 Section Number 1 Township Number T 27 S Range Number R 2 E

Distance and direction from nearest town or city street address of well if located within city?

2312 Cedar Crest Wichita

2 WATER WELL OWNER: Odell Construction


RR#, St. Address, Box #: 14126 Valley Hi Rd.

City, State, ZIP Code: Wichita, KS 67235

Board of Agriculture, Division of Water Resources

Application Number:

3 LOCATE WELL'S LOCATION WITH AN "X" IN SECTION BOX:

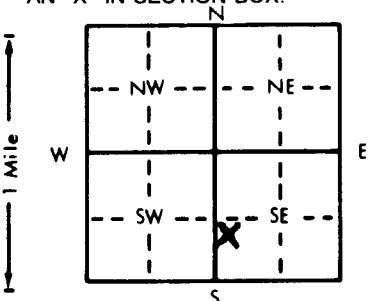

4 DEPTH OF COMPLETED WELL: 65 ft. ELEVATION:

Depth(s) Groundwater Encountered 1. 28 ft. 2. 28 ft. 3. 28 ft.

WELL'S STATIC WATER LEVEL 28 ft. below land surface measured on mo/day/yr 7-14-81

Pump test data: Well water was 29 ft. after 1/2 hours pumping 20 gpm

Est. Yield 50 gpm: Well water was 29 ft. after 1/2 hours pumping 20 gpm

Bore Hole Diameter 11 in. to 65 ft., and 65 in. to 65 ft.

WELL WATER TO BE USED AS: 5 Public water supply 8 Air conditioning 11 Injection well

1 Domestic 3 Feedlot 6 Oil field water supply 9 Dewatering 12 Other (Specify below)

2 Irrigation 4 Industrial 7 Lawn and garden only 10 Observation well

Was a chemical/bacteriological sample submitted to Department? Yes X No X; If yes, mo/day/yr sample was submitted

Water Well Disinfected? Yes X No X

5 TYPE OF BLANK CASING USED:

1 Steel 3 RMP (SR)

2 PVC 4 ABS

5 Wrought iron

6 Asbestos-Cement

7 Fiberglass

8 Concrete tile

9 Other (specify below)

CASING JOINTS: Glued X Clamped

Welded

Threaded

Blank casing diameter 5 in. to 53 ft., Dia 53 in. to 53 ft., Dia 53 in. to 53 ft.

Casing height above land surface 1.2 in., weight 1.59 lbs./ft. Wall thickness or gauge No. 50R26

TYPE OF SCREEN OR PERFORATION MATERIAL:

1 Steel 3 Stainless steel

2 Brass 4 Galvanized steel

5 Fiberglass

6 Concrete tile

7 PVC

8 RMP (SR)

9 ABS

10 Asbestos-cement

11 Other (specify)

12 None used (open hole)

SCREEN OR PERFORATION OPENINGS ARE:

1 Continuous slot

2 Louvered shutter

3 Mill slot

4 Key punched

5 Gauzed wrapped

6 Wire wrapped

7 Torch cut

8 Saw cut

9 Drilled holes

10 Other (specify)

11 None (open hole)

SCREEN-PERFORATED INTERVALS: From 53 ft. to 65 ft., From 53 ft. to 65 ft., From 53 ft. to 65 ft.

GRAVEL PACK INTERVALS: From 13 ft. to 65 ft., From 13 ft. to 65 ft., From 13 ft. to 65 ft.

6 GROUT MATERIAL:

1 Neat cement

2 Cement grout

3 Bentonite

4 Other

Grout Intervals: From 3 ft. to 13 ft., From 3 ft. to 13 ft., From 3 ft. to 13 ft.

What is the nearest source of possible contamination:

1 Septic tank

2 Sewer lines

3 Watertight sewer lines 6 Seepage pit

4 Lateral lines

5 Cess pool

7 Pit privy

8 Sewage lagoon

9 Feedyard

10 Livestock pens

11 Fuel storage

12 Fertilizer storage

13 Insecticide storage

14 Abandoned water well

15 Oil well/Gas well

16 Other (specify below)

Direction from well?

EAST

How many feet? 75

FROM	TO	LITHOLOGIC LOG	FROM	TO	LITHOLOGIC LOG
0	2	Top soil			
2	17	Red clay			
17	28	med. sand			
28	30	Red clay			
30	40	med sand			
40	42	gray clay			
42	48	med sand			
48	50	gray clay			
50	65	coarse gravel/sand			

7 CONTRACTOR'S OR LANDOWNER'S CERTIFICATION: This water well was (1) constructed, (2) reconstructed, or (3) plugged under my jurisdiction and was completed on (mo/day/year) 7-14-81 and this record is true to the best of my knowledge and belief. Kansas

Water Well Contractor's License No. 318 This Water Well Record was completed on (mo/day/yr) 7-21-81

under the business name of Weninger Pumping by (signature) Promet Weninger

INSTRUCTIONS: Use typewriter or ball point pen, PLEASE PRESS FIRMLY and PRINT clearly. Please fill in blanks, underline or circle the correct answers. Send top three copies to Kansas Department of Health and Environment, Division of Environment, Environmental Geology Section, Topeka, KS 66620. Send one to WATER WELL OWNER and retain one for your records.

OFFICE USE ONLY

T

R

FW

SEC.

1

2

3

4