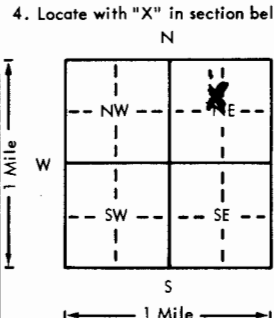


USE TYPEWRITER OR BALL
POINT PEN-PRESS FIRMLY,
PRINT CLEARLY.

WATER WELL RECORD
KSA 82a-1201-1215

Kansas Department of Health and
Environment-Division of Environment
(Water well Contractors)
Topeka, Kansas 66620

1. Location of well:	County: <u>Sedgwick</u>	Fraction: <u>SE 1/4 NW 1/4 NE 1/4</u>	Section number: <u>5</u>	Township number: <u>T 27 S</u>	Range number: <u>R 2 W</u>
2. Distance and direction from nearest town or city: <u>1/4 E 1/4 So. St. Marks Ks</u>		3. Owner of well: <u>Dennis Eck</u> R.R. or street: <u>R.F.G. #1</u> City, state, zip code: <u>Hope Ks 67108</u>			
4. Locate with "X" in section below: 		Sketch map: 		6. Bore hole dia. <u>80</u> in. Completion date: <u>4/17/78</u> Well depth <u>80</u> ft.	
5. Type and color of material		From		To	
		<u>Top Soil</u>		<u>0</u>	<u>3</u>
		<u>green shale</u>		<u>3</u>	<u>33</u>
		<u>charcoal shale</u>		<u>33</u>	<u>80</u>
				7. ☒ Cable tool ☒ Rotary ☐ Driven ☐ Dug ☐ Hollow rod ☐ Jetted ☐ Bored ☐ Reverse rotary	
				8. Use: ☒ Domestic ☐ Public supply ☐ Industry ☐ Irrigation ☐ Air conditioning ☐ Stock ☐ Lawn ☐ Oil field water ☐ Other	
				9. Casing: Material <u>Styrene</u> Height: <u>0</u> in. above or below Threaded ☐ Welded ☒ Surface <u>1 1/2</u> in. RMP ☒ PVC ☐ Weight <u>1.50</u> lbs./ft. Dia. <u>3</u> in. to <u>80</u> ft. depth Wall Thickness: inches or Dia. <u> </u> in. to <u> </u> ft. depth gage No. <u>200</u>	
				10. Screen: Manufacturer's name <u>Sunflower</u> Type <u>200</u> Dia. <u>5</u> in. Gauze <u>146</u> Length <u>50</u> ft. Set between <u>30</u> ft. and <u>80</u> ft. Gravel pack <u>yes</u> Size range of material <u>3/8</u>	
				11. Static water level: <u>15</u> ft. below land surface Date <u>4/17/78</u>	
				12. Pumping level below land surfaces: <u>38</u> ft. after <u>12</u> hrs. pumping <u>10</u> g.p.m. <u> </u> ft. after <u> </u> hrs. pumping <u> </u> g.p.m. Estimated maximum yield <u>30</u> g.p.m.	
				13. Water sample submitted: <u> </u> mo./day/yr. ☐ Yes ☒ No Date <u> </u>	
				14. Well head completion: ☐ Pitless adapter <u>12</u> inches above grade	
				15. Well grouted? <u>yes</u> With: ☐ Neat cement ☐ Bentonite ☒ Concrete Depth: From <u>3</u> ft. to <u>13</u> ft.	
				16. Nearest source of possible contamination: ft. <u>90</u> Direction <u>SW</u> Type <u>Septic</u> Well disinfected upon completion? ☒ Yes ☐ No	
				17. Pump: ☒ Not installed Manufacturer's name <u> </u> Model number <u> </u> HP <u> </u> Volts <u> </u> Length of drop pipe <u> </u> ft. capacity <u> </u> g.p.m. Type: ☐ Submersible ☐ Turbine ☐ Jet ☐ Reciprocating ☐ Centrifugal ☐ Other	
18. Elevation:		19. Remarks:		20. Water well contractor's certification:	
Topography: ☐ Hill ☐ Slope ☒ Upland ☐ Valley		<u>Customer to furnish 4'x4'x4'</u> <u>slab around casing at grade</u> <u>per State Regulations</u> <u>Signed X Dennis Eck</u>		This well was drilled under my jurisdiction and this report is true to the best of my knowledge and belief. Business name <u>Weninger Pumping</u> 318 Address <u>Topeka</u> Signed <u>John Weninger</u> 4/17/78 Authorized Representative	

Forward the white, blue and pink copies to the Department of Health and Environment

Form WWC-5