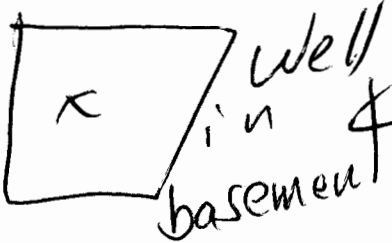


USE TYPEWRITER OR BALL
POINT PEN-PRESS FIRMLY,
PRINT CLEARLY.

WATER WELL RECORD
KSA 82a-1201-1215

T R EW sec 1/4 1/4 1/4 No.

Kansas State Dept. Of Health
(Water Well Contractors)
Forbes-Bldg. 740
Topeka, Kansas 66620

1 Location of well: County: <u>Sedg</u>		Township name: <u>Attica SENESE</u>		Fraction: <u>8</u>	Section number: <u>27 S</u>	Town number: <u>2 W</u>	Range number: <u>8</u>
Distance and direction from nearest town or city: <u>4 So 1 W 3/4 So of Colwich KS.</u>				3 Owner of well: <u>Albert Mies</u> Address: <u>R#1 Colwich KS. 67030</u>			
Locate with "X" in section below: N W E S 1 Mile		Sketch map: 		4 Well depth: <u>65</u> ft. Date of completion: <u>4/26/77</u> Well diameter: <u>5</u> in. <u>11"</u>			
2 Type and color of material		From		To		5 ☐ Cable tool ☒ Rotary ☐ Driven ☐ Dug ☐ Hollow rod ☐ Jetted ☐ Bored ☐ Reverse rotary	
						6 Use: ☒ Domestic ☐ Public supply ☐ Industry ☐ Irrigation ☐ Air conditioning ☐ Commercial ☐ Test well	
						7 Casing: Material <u>PC</u> Height: above/below Threaded ☐ Welded ☐ Surface <u>12</u> in. Diam. <u>5</u> in. to <u>65</u> ft. depth: Drive shoe? ☐ Yes ☒ No	
						8 Screen: Manufacturer: <u>Pumpco MPI</u> Type: <u>PC</u> Dia: <u>5 in</u> Slot/gauze: <u>1/16</u> Length: <u>5 ft</u> Set between <u>60</u> ft. and <u>65</u> ft. Fittings: ☒ Yes ☐ No Size range of material: <u>3/8</u>	
						9 Static water level: <u>18</u> ft. below land surface Date: <u>4/26/77</u>	
						10 Pumping level below land surfaces: <u>18</u> ft. after <u>1/2</u> hrs. pumping <u>20</u> g.p.m. ____ ft. after ____ hrs. pumping ____ g.p.m. Estimated maximum yield: <u>50</u> g.p.m.	
						11 Water sample submitted: ☐ Yes ☒ No Date: ____	
						12 Well head completion: ☐ Pitless adapter ☒ 12 inches above grade	
						13 Well grouted? ☒ Yes ☐ No ☒ Neat cement ☐ Bentonite Depth: From <u>18</u> ft. to <u>18</u> ft.	
						14 Nearest source of possible contamination: ft. ____ Direction: <u>none</u> Type: ____ Well disinfected upon completion? ☒ Yes ☐ No	
						15 Pump: ☒ Not installed Manufacturer's name: ____ Model number: ____ HP: ____ Volts: ____ Length of drop pipe: ____ ft. capacity: ____ g.m.p. Type: ☐ Submersible ☐ Turbine ☐ Jet ☐ Reciprocating ☐ Centrifugal ☐ Other	
16 Remarks: elevation						17 Water well contractor's certification: This well was drilled under my jurisdiction and this report is true to the best of my knowledge and belief. Business name: <u>Church</u> License No. <u>318</u> Address: <u>Colwich</u> Authorized representative: <u>Church</u> Date: <u>4/26/77</u>	

Forward the white, blue and pink copies to the Kansas State Dept. Of Health.

Form WWC-5