

PHONE
PA 2-1411

HARP WELL & PUMP SERVICE, INC.

PUMP SALES & SERVICE
215 SO. TYLER ROAD
WICHITA, KANSAS 67209


SOLD TO

DATE November 14, 1975

Kansas Department of Health
Attention: Dewight Brinkley
Division of Environment
(Water Well Contractors)
Topeka, Kansas 66620

Re: Jim Geelsby
1551 South 151st West
Goddard, Kansas
Job - 1437 Tapastry
Goddard, Kansas

TERMS NET - 8% INTEREST CHARGED ON OVER DUE ACCOUNTS

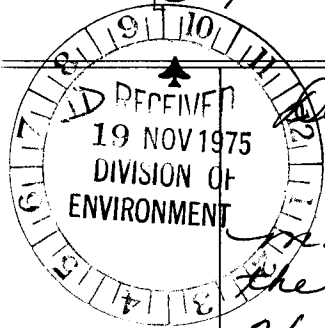

Dear Mr. Brinkley:

Please note that an error was made on the section number in the legal description on this log. The copy reads section #10.

The correct legal description is as follows: Sedgwick County, SE 1/4, SE 1/4, Section #27, Town 27S, R2W,

We apologize for this error.

Sincerely,
Harp Well & Pump Service, Inc.

USE TYPEWRITER OR BALL
POINT PEN-PRESS FIRMLY,
PRINT CLEARLY.

WATER WELL RECORD
KSA 82a-1201-1215

Kansas Department of Health and
Environment-Division of Environment
(Water well Contractors)
Topeka, Kansas 66620

27

1. Location of well: <u>Sedgwick</u> County		Fraction <u>SWNE 1/4 SE 1/4 SE 1/4</u>		Section number <u>10</u>	Township number <u>27</u> S R <u>2</u> E W <u>0</u>
2. Distance and direction from nearest town or city: <u>1437</u> Street address of well location if in city: <u>155 1/2 South 151st West</u> <u>Goddard, KS</u>				3. Owner of well: <u>Jim Goshy</u> R.R. or street: <u>155 1/2 South 151st West</u> City, state, zip code: <u>Goddard, KS 67052</u>	
4. Locate with "X" in section below: N W E S 1 Mile		Sketch map:		6. Bore hole dia. <u>11</u> in. Completion date _____ Well depth <u>112</u> ft.	
5. Type and color of material		From		To	
		Dirt		0	2
		Grey Clay		2	15
		Blue Shale		15	60
		Red Shale		60	70
Blue Shale		70	110		
				10. Screen: Manufacturer's name <u>Shallower Plastic</u> Type <u>Thyrene</u> Dia. <u>5"</u> Slot/gauze <u>.050</u> Length <u>70'</u> Set between <u>40</u> ft. and <u>110</u> ft. Gravel pack? <u>yes</u> Size range of material <u>1/4-1/8"</u>	
				11. Static water level: _____ mo./day/yr. <u>30</u> ft. below land surface Date _____	
				12. Pumping level below land surfaces: _____ ft. after _____ hrs. pumping _____ g.p.m. _____ ft. after _____ hrs. pumping _____ g.p.m. Estimated maximum yield _____ g.p.m.	
				13. Water sample submitted: _____ mo./day/yr. Yes _____ No _____ Date _____	
				14. Well head completion: <u>12</u> capped Pitless adapter _____ inches above grade	
				15. Well grouted? <u>yes</u> With: _____ Nept cement _____ Bentonite _____ Concrete <u>X</u> Depth: From <u>40"</u> to <u>14</u> ft.	
				16. Nearest source of possible contamination: <u>None</u> ft. _____ Direction _____ Type _____ Well disinfected upon completion? <u>X</u> Yes _____ No _____	
				17. Pump: <u>X</u> Not installed Manufacturer's name _____ Model number _____ HP _____ Volts _____ Length of drop pipe _____ ft. capacity _____ g.p.m. Type: _____ Submersible _____ Turbine _____ Jet _____ Reciprocating _____ Centrifugal _____ Other _____	
18. Elevation: _____ Topography: _____ _____ Hill _____ Slope _____ Upland _____ Valley		19. Remarks: <u>I lat Ground</u> <u>Septic Tank not Installed</u> <u>when well was</u> <u>drilled</u> <u>No apparent source for</u> <u>contamination.</u>		20. Water well contractor's certification: This well was drilled under my jurisdiction and this report is true to the best of my knowledge and belief. <u>Hard Well Pump 236</u> Business name _____ License No. _____ Address <u>Hechita, Kansas</u> Signed <u>M. Arnold</u> Date _____ Authorized representative	

Forward the white, blue and pink copies to the Department of Health and Environment

Form WWC-5