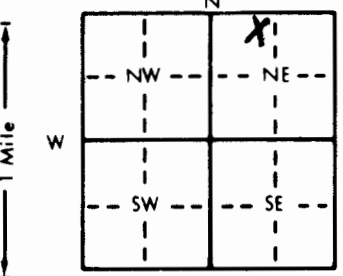


1 LOCATION OF WATER WELL: County: <u>Sedgwick</u>	Fraction NE 1/4 NW 1/4 NE 1/4	Section Number <u>12</u>	Township Number T <u>27</u> S	Range Number R <u>2W</u> E/W
--	----------------------------------	-----------------------------	----------------------------------	---------------------------------

Distance and direction from nearest town or city street address of well if located within city?

2006 Tealbrook Wichita, Kansas

2 WATER WELL OWNER: <u>Vogel, Wayne</u> RR#, St. Address, Box # : <u>2006 Tealbrook</u> City, State, ZIP Code : <u>Wichita, Kansas</u>	Board of Agriculture, Division of Water Resources Application Number:
--	--

Department? Yes <u>X</u> No <u>X</u> If yes, mo/day/yr sample was submitted Water Well Disinfected? Yes <u>X</u> No
--	--


TYPE OF SCREEN OR PERFORATION MATERIAL: 1 Steel 3 Stainless steel 5 Fiberglass 8 RMP (SR) 2 Brass 4 Galvanized steel 6 Concrete tile 9 ABS	10 Asbestos-cement 11 Other (specify) 12 None used (open hole)
SCREEN OR PERFORATION OPENINGS ARE: 1 Continuous slot 3 Mill slot 5 Gauzed wrapped 8 Saw cut 2 Louvered shutter 4 Key punched 6 Wire wrapped 9 Drilled holes 7 Torch cut 10 Other (specify)	11 None (open hole)
SCREEN-PERFORATED INTERVALS: From <u>55</u> ft. to <u>95</u> ft. From <u>55</u> ft. to <u>95</u> ft. GRAVEL PACK INTERVALS: From <u>24</u> ft. to <u>95</u> ft. From <u>24</u> ft. to <u>95</u> ft.	

6 GROUT MATERIAL: 1 Neat cement 2 Cement grout 3 Bentonite 4 Other Grout intervals: From <u>4</u> ft. to <u>24</u> ft. From <u>4</u> ft. to <u>24</u> ft. From <u>4</u> ft. to <u>24</u> ft.	What is the nearest source of possible contamination: 1 Septic tank 4 Lateral lines 7 Pit privy 10 Livestock pens 14 Abandoned water well 2 Sewer lines 5 Cess pool 8 Sewage lagoon 11 Fuel storage 15 Oil well/Gas well 3 Watertight sewer lines 6 Seepage pit 9 Feedyard 12 Fertilizer storage 16 Other (specify below) 13 Insecticide storage
---	--

Direction from well? <u>South</u>	How many feet? <u>100</u>
FROM TO LITHOLOGIC LOG FROM TO PLUGGING INTERVALS	
0 3 topsoil	
3 17 clay	
17 35 fine sand	
35 50 medium sand and clay	
50 78 fine sand and clay	
78 95 medium sand	

7 CONTRACTOR'S OR LANDOWNER'S CERTIFICATION: This water well was (1) constructed, (2) reconstructed, or (3) plugged under my jurisdiction and was completed on (mo/day/year) <u>3-21-91</u> and this record is true to the best of my knowledge and belief. Kansas Water Well Contractor's License No. <u>236</u> This Water Well Record was completed on (mo/day/yr) <u>5-1-91</u> under the business name of <u>Harp Well and Pump Service, Inc.</u> by (signature) <u>Mary Arnold</u>
--

INSTRUCTIONS: Use typewriter or ball point pen. PLEASE PRESS FIRMLY and PRINT clearly. Please fill in blanks, underline or circle the correct answers. Send top three copies to Kansas Department of Health and Environment, Bureau of Water, Topeka, Kansas 66620-7320. Telephone: 913-296-5545. Send one to WATER WELL OWNER and retain one for your records.