

1 LOCATION OF WATER WELL:		Fraction	Section Number		Township Number		Range Number	
County:	SEDGWICK	SW 1/4 SE 1/4	12		T 27 S		R 2W 1/4	


12330 Nantuckett	Cedar Park Estates	Wichita, Kansas
------------------	--------------------	-----------------

2	WATER WELL OWNER:	John Schott	
	RR#, St. Address, Box # :	1630 Rutters	Board of Agriculture, Division of Water Resources
	City, State, ZIP Code :	Wichita, KS.	Application Number:

3	LOCATE WELL'S LOCATION WITH AN "X" IN SECTION BOX:	4	DEPTH OF COMPLETED WELL..... 50 ft. ELEVATION:
---	--	---	--

Depth(s) Groundwater Encountered 120 ft. 2. ft. 3. ft. 10-29-85

WELL'S STATIC WATER LEVEL 20 ft. below land surface measured on mo/day/yr

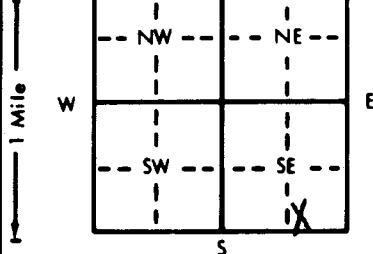

Pump test data: Well water was ft. after hours pumping gpm
Est. Yield gpm: Well water was ft. after hours pumping gpm
Bore Hole Diameter 11 in. to ft., and in. to ft.
WELL WATER TO BE USED AS:
 1 Domestic 3 Feedlot 6 Oil field water supply 8 Air conditioning 11 Injection well
 2 Irrigation 4 Industrial 7 ~~Lawn and garden only~~ 9 Dewatering 12 Other (Specify below)

Was a chemical/bacteriological sample submitted to Department? Yes.....No.....XX If yes, mo/day/yr sample was sub-
mitted Water Well Disinfected? Yes XX No

5 TYPE OF BLANK CASING USED:		5 Wrought iron	8 Concrete tile	- CASING JOINTS: Glued ^{XX}	Clamped
1 Steel	<u>3 RMP (SB)</u>	6 Asbestos-Cement	9 Other (specify below)	Welded	
2 PVC	4 ABS	7 Fiberglass	<u>Cer-Mac styrene SDR-26</u>	Threaded	
Blank casing diameter		<u>5</u> in. to <u>30</u> ft., Dia	in. to . ft., Dia in. to . ft.		
Casing height above land surface		<u>12</u> in. weight	<u>1.59</u> lbs./ft.	Wall thickness or gauge No. <u>.203</u>	

TYPE OF SCREEN OR PERFORATION MATERIAL:			7 PVC	10 Asbestos-cement
1 Steel	3 Stainless steel	5 Fiberglass	<u>8 RMP</u> (SR)	11 Other (specify)
2 Brass	4 Galvanized steel	6 Concrete tile	9 ABS	12 None used (open hole)

SCREEN OR PERFORATION OPENINGS ARE:

1 Continuous slot	3 Mill slot	5 Gauzed wrapped	8 Saw cut	11 None (open hole)
2 Louvered shutter	4 Key punched	6 Wire wrapped	9 Drilled holes	
		7 Torch cut	10 Other (specify)	

SCREEN-PERFORATED INTERVALS:	From 30	ft. to 50	ft., From	ft. to	ft.
	From	ft. to	ft., From	ft. to	ft.
GRAVEL PACK INTERVALS:	From 14	ft. to 50	ft., From	ft. to	ft.
	From	ft. to	ft., From	ft. to	ft.

6 GROUT MATERIAL: 1 Neat cement 2 Cement grout 3 Bentonite 4 Other

Grout Intervals: From 4 ft. to 14 ft. From ft. to ft. From ft. to ft.

What is the nearest source of possible contamination:

1 Septic tank	4 Lateral lines	7 Pit privy	10 Livestock pens	14 Abandoned water well
2 Sewer lines	5 Cess pool	8 Sewage lagoon	11 Fuel storage	15 Oil well/Gas well
3 Watertight sewer lines	6 Seepage pit	9 Feedyard	12 Fertilizer storage	16 Other (specify below)

Direction from well? SW

How many feet? 65'

[illegible]

7 CONTRACTOR'S OR LANDOWNER'S CERTIFICATION: This water well was (1) constructed, (2) reconstructed, or (3) plugged under my jurisdiction and was completed on (mo/day/year) 10-29-85 and this record is true to the best of my knowledge and belief. Kansas Water Well Contractor's License No. 236 This Water Well Record was completed on (mo/day/yr) 3-30-86 under the business name of Harp Well & Pump Service, Inc. by (signature) Mary Arnold

INSTRUCTIONS: Use typewriter or ball point pen. PLEASE PRESS FIRMLY and PRINT clearly. Please fill in blanks, underline or circle the correct answers. Send top three copies to Kansas Department of Health and Environment, Office of Oil Field and Environmental Geology, Regulation and Permitting Section, Topeka, Kansas 66620-7500, Telephone: 913-862-9360. Send one to WATER WELL OWNER and retain one for your records.