USE TYPEWRITER OR BALL POINT PEN-PRESS FIRMLY, PRINT CLEARLY.

WATER WELL RECORD
KSA 82a-1201-1215

Kansas Department of Health and Environment-Division of Environment
(Water well Contractors)
Topeka, Kansas 66620

1. Location of well:	County	Fraction	Section number	Township number	Range number
	SEDGWICK	1/4 NW 1/4 NE 1/4	13	T 27 S	R 2W E/W

2. Distance and direction from nearest town or city: 1301 Firefly Dr. Wichita, Kansas
Street address of well location if in city:

3. Owner of well: Eldon Schierling
R.R. or street: 425 Cheryl
City, state, zip code: Wichita, Kansas

4. Locate with "X" in section below: Sketch map:

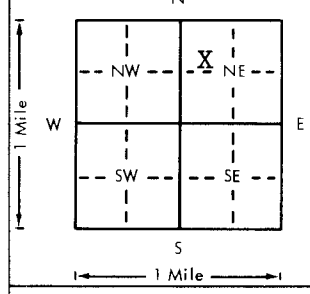

6. Bore hole dia. 11 in. Completion date
Well depth 80 ft. 7-22-78

7. ___ Cable tool X Rotary ___ Driven ___ Dug
___ Hollow rod ___ Jetted ___ Bored ___ Reverse rotary

8. Use: X Domestic ___ Public supply ___ Industry
___ Irrigation ___ Air conditioning ___ Stock
___ Lawn ___ Oil field water ___ Other

9. Casing: Material styrene Height: Above or below ///
Threaded ___ Welded gl Surface 12 in.
RMP X PVC ___ Weight ___ lbs./ft.
Dia. 5 in. to 80 ft. depth Wall Thickness: inches or
Dia. ___ in. to ___ ft. depth gage No. .200

5. Type and color of materiol	From	To
Topsoil	0	2
Clay	2	16
Sandy Clay	16	21
Medium sand with Clay Streaks	21	24
Coarse Sand	24	30
Clay	30	38
Fine Sand	38	60
Medium Sand	60	80

(Use a second sheet if needed)

10. Screen: Manufacturer's name Sunflower Plastic
Type styrene Dia. 5"
Slot/gauze .06 Length 20'
Set between 60 ft. and 80 ft.
___ ft. and ___ ft.
Gravel pack? yes Size range of material 1/4-1/8"

11. Static water level: mo./day/yr.
16 ft. below land surface Date 7-22-78

12. Pumping level below land surfaces:
___ ft. after ___ hrs. pumping ___ g.p.m.
___ ft. after ___ hrs. pumping ___ g.p.m.
Estimated maximum yield ___ g.p.m.

13. Water sample submitted: mo./day/yr.
___ Yes ___ No Dote

14. Well head completion: capped
___ Pitless adapter 12 Inches above grade

15. Well grouted? yes 1-2Fine Sand Mix
With: ___ Neat cement ___ Bentonite X Concrete
Depth: From 6 ft. to 16 ft.

16. Nearest source of possible contamination:
ft. ___ Direction ___ Type NONE
Well disinfected upon completion? X Yes ___ No

17. Pump: X Nat installed
Manufocturer's name
Model number ___ HP ___ Volts ___
Length of drop pipe ___ ft. capacity ___ g.p.m.
Type:
___ Submersible ___ Turbine
___ Jet ___ Reciprocating
___ Centrifugal ___ Other

18. Elevation:

Topography:
___ Hill
___ Slope
___ Uplond
___ Valley

19. Remarks:
Flat Ground

Septic system not installed at this time.
No apparent source for contamination.

20. Water well contractor's certification:
This well was drilled under my jurisdiction and this report is true to the best of my knowledge and belief.
Harp Well & Pump 236
Business name License No.
Address Wichita, Kansas 67209
Signed M. Arnold Date 8-2-78
Authorized representative

T 27 R 2W E/W Sec 13 1/4 1/4 1/4 NWNE

Forward the white, blue and pink copies to the Department of Health and Environment

Form WWC-5

MI-1023