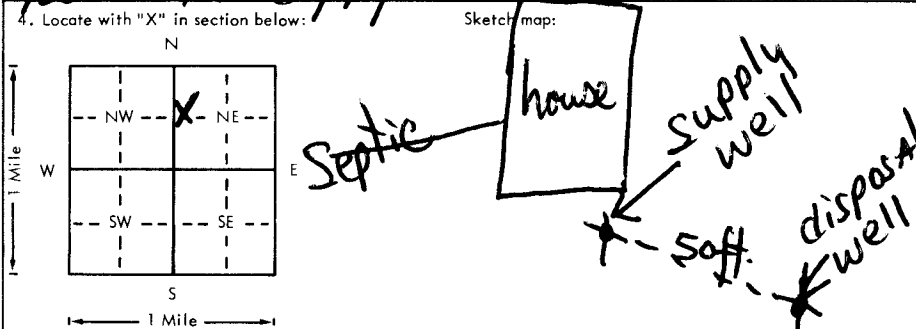


USE TYPEWRITER OR BALL
POINT PEN-PRESS FIRMLY,
PRINT CLEARLY.

WATER WELL RECORD
KSA 82a-1201-1215

Kansas Department of Health and
Environment-Division of Environment
(Water well Contractors)
Topeka, Kansas 66620

1. Location of well: County <u>Sedgwick</u> Fraction <u>SW 1/4 NW 1/4 NE 1/4</u> Section number <u>13</u> Township number <u>T 27 S</u> Range number <u>R 2 E</u>																									
2. Distance and direction from nearest town or city: Street address of well location if in city: <u>1233 E. Reilly</u>																									
3. Owner of well: <u>Sherman Gippson</u> R.R. or street: <u>303 Wheatland</u> City, state, zip code: <u>Wichita KS 67235</u>																									
4. Locate with "X" in section below: Sketch map: 																									
5. Type and color of material																									
<table border="1"> <thead> <tr> <th></th> <th>From</th> <th>To</th> </tr> </thead> <tbody> <tr> <td>Top Soil</td> <td>0</td> <td>4</td> </tr> <tr> <td>red clay</td> <td>4</td> <td>24</td> </tr> <tr> <td>fine sand</td> <td>24</td> <td>42</td> </tr> <tr> <td>red clay</td> <td>42</td> <td>46</td> </tr> <tr> <td>fine sand.</td> <td>46</td> <td>61</td> </tr> <tr> <td>red clay</td> <td>61</td> <td>62</td> </tr> <tr> <td>med. gravel.</td> <td>62</td> <td>80</td> </tr> </tbody> </table>			From	To	Top Soil	0	4	red clay	4	24	fine sand	24	42	red clay	42	46	fine sand.	46	61	red clay	61	62	med. gravel.	62	80
	From	To																							
Top Soil	0	4																							
red clay	4	24																							
fine sand	24	42																							
red clay	42	46																							
fine sand.	46	61																							
red clay	61	62																							
med. gravel.	62	80																							
6. Bore hole dia. <u>11</u> in. Completion date <u>4/24/78</u> Well depth <u>80</u> ft.																									
7. ☒ Cable tool ☒ Rotary ☐ Driven ☐ Dug ☐ Hollow rod ☐ Jetted ☐ Bored ☐ Reverse rotary																									
8. Use: ☐ Domestic ☐ Public supply ☐ Industry ☐ Irrigation ☐ Air conditioning ☐ Stock ☒ Heat pump ☒ Disposal																									
11. Static water level: <u>28</u> ft. below land surface Date <u>4/25/78</u>																									
12. Pumping level below land surfaces: <u>30</u> ft. after <u>1/2</u> hrs. pumping <u>20</u> g.p.m. <u>30</u> ft. after <u>1</u> hrs. pumping <u>20</u> g.p.m. Estimated maximum yield <u>20</u> g.p.m.																									
13. Water sample submitted: <u>Yes</u> ☒ No Date <u>4/25/78</u>																									
14. Well head completion: ☒ Pitless adapter <u>12</u> inches above grade																									
15. Well grouted? <u>Yes</u> With: <u>Neat cement</u> ☒ Bentonite ☒ Concrete Depth: From <u>3</u> ft. to <u>13</u> ft.																									
16. Nearest source of possible contamination: <u>100</u> ft. Direction <u>W</u> Type <u>Septic</u> Well disinfected upon completion? ☒ Yes ☐ No																									
18. Elevation: Topography: ☒ Hill ☐ Slope ☐ Upland ☐ Valley																									
19. Remarks: <u>Customer to furnish 4x4x4" slab at grade around casing per State Regulations</u> <u>Signed X Sherma Gippson</u>																									

Forward the white, blue and pink copies to the Department of Health and Environment

Form WWC-5