

1 LOCATION OF WATER WELL: Section Number Township Number Range Number
 County: Sedgwick NW 1/4 SW 1/4 SE 1/4 25 T 37 S R 2 E/W

Distance and direction from nearest town or city street address of well if located within city?

See Below

2 WATER WELL OWNER:

RR#, St. Address, Box #

City, State, ZIP Code


1511 Hill Hornecker
 Wichita KS

Board of Agriculture, Division of Water Resources

Application Number:

3 LOCATE WELL'S LOCATION WITH AN "X" IN SECTION BOX:

4 DEPTH OF COMPLETED WELL: 111 ft. ELEVATION:

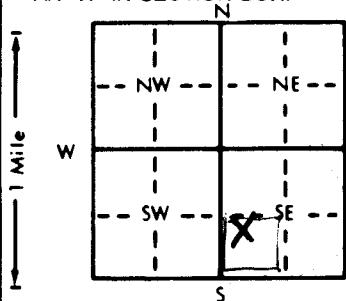

Depth(s) Groundwater Encountered 1. 18 ft. 2. 18 ft. 3. 18 ft.

WELL'S STATIC WATER LEVEL 18 ft. below land surface measured on mo/day/yr 2/22/94

Pump test data: Well water was 18 ft. after 12 hours pumping 25 gpm

Est. Yield 50 gpm: Well water was 18 ft. after 12 hours pumping 25 gpm

Bore Hole Diameter 11 in. to 11 in. ft., and 11 in. to 11 in. ft.

WELL WATER TO BE USED AS: 5 Public water supply 8 Air conditioning 11 Injection well

1 Domestic 3 Feedlot 6 Oil field water supply 9 Dewatering 12 Other (Specify below)

2 Irrigation 4 Industrial 7 Lawn and garden only 10 Monitoring well

Was a chemical/bacteriological sample submitted to Department? Yes No

Water Well Disinfected? Yes No

5 TYPE OF BLANK CASING USED:

- 1 Steel 3 RMP (SR)
 2 PVC 4 ABS

- 5 Wrought iron 8 Concrete tile
 6 Asbestos-Cement 9 Other (specify below)
 7 Fiberglass

CASING JOINTS: Glued X Clamped
 Welded
 Threaded

Blank casing diameter 5 in. to 102 ft. Dia 2 in. to 20 in. Dia 160 PSI

Casing height above land surface 12 in. weight 220 lbs./ft. Wall thickness or gauge No. 160 PSI

TYPE OF SCREEN OR PERFORATION MATERIAL:

- 1 Steel 3 Stainless steel
 2 Brass 4 Galvanized steel

- 5 Fiberglass 8 RMP (SR)
 6 Concrete tile 9 ABS

- 7 PVC 10 Asbestos-cement
 11 Other (specify)
 12 None used (open hole)

SCREEN OR PERFORATION OPENINGS ARE:

- 1 Continuous slot 3 Mill slot
 2 Louvered shutter 4 Key punched

- 5 Gauzed wrapped 8 Saw cut 11 None (open hole)
 6 Wire wrapped 9 Drilled holes
 7 Torch cut 10 Other (specify)

SCREEN-PERFORATED INTERVALS: From 102 ft. to 111 ft. From 111 ft. to 111 ft.

GRAVEL PACK INTERVALS: From 102 ft. to 111 ft. From 111 ft. to 111 ft.

6 GROUT MATERIAL:

- 1 Neat cement 2 Cement grout

- 3 Bentonite 4 Other

Grout Intervals: From 3 ft. to 102 ft. From 102 ft. to 111 ft.

What is the nearest source of possible contamination:

- 1 Septic tank 4 Lateral lines 7 Pit privy
 2 Sewer lines 5 Cess pool 8 Sewage lagoon
 3 Watertight sewer lines 6 Seepage pit 9 Feedyard

- 10 Livestock pens 14 Abandoned water well
 11 Fuel storage 15 Oil well/Gas well
 12 Fertilizer storage 16 Other (specify below)
 13 Insecticide storage

Direction from well?

How many feet?

FROM	TO	LITHOLOGIC LOG	FROM	TO	PLUGGING INTERVALS
0	2	top soil			
2	81	clay			
81	84	fine sand			
84	102	clay			
102	111	gravel			

7 CONTRACTOR'S OR LANDOWNER'S CERTIFICATION: This water well was (1) constructed, (2) reconstructed, or (3) plugged under my jurisdiction and was completed on (mo/day/year) 2-22-94 and this record is true to the best of my knowledge and belief. Kansas

Water Well Contractor's License No. 318

under the business name of Weninger Drilling Inc

This Water Well Record was completed on (mo/day/yr) 2-22-94

by (signature) Susan E. Weninger