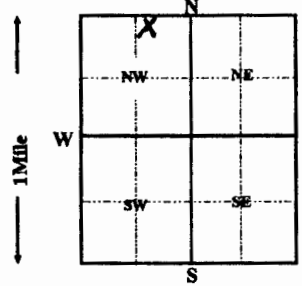


1 LOCATION OF WATER WELL: Sedgwick	FRACTION NW 1/4 NE 1/4 NW 1/4	Section Number 27	Township Number T 27 S	Range Number R 2W E/W
Distance and direction from nearest town or city street address of well if located within city? 400 S. 162nd West Goddard, Kansas				
2 WATER WELL OWNER: UTSLER, George RR#, ST. ADDRESS, BOX #: 24617 Pheasant Ct. CITY, STATE, ZIP CODE: Viola, Kansas plugged 67149				
Board of Agriculture, Division of Water Resource Application Number:				
3 LOCATE WELL'S LOCATION WITH AN "X" IN SECTION BOX: 	4 DEPTH OF COMPLETED WELL 67 ft. ELEVATION: Depth(s) groundwater Encountered 1 ft. 2 ft. 3 ft. WELL'S STATIC WATER LEVEL 17 FT. BELOW LAND SURFACE MEASURED ON mo/day/yr 03/10/1993 Pump test data: Well water was ft. after hours pumping gpm Est. Yield gpm: Well water was ft. after hours pumping gpm Bore Hole Diameter in. to ft., and in. to ft. WELL WATER TO BE USED AS: 5 Public water supply 8 Air conditioning 11 Injection well 1 Domestic 3 Feedlot 6 Oil field water supply 9 Dewatering 12 Other (Specify below) 2 Irrigation 4 Industrial 7 Lawn and garden only 10 Monitoring well Was a chemical/bacteriological sample submitted to Department? Yes No ; If yes, mo/day/yr sample was submitted Water Well Disinfected? Yes X No			
5 TYPE OF CASING USED: 1 Steel 3 RMP (SR) 5 Wrought iron 8 Concrete tile CASING JOINTS: Glued Clamped 2 PVC 4 ABS 6 Asbestos-Cement 9 Other (Specify below) Welded 7 Fiberglass Threaded Blank casing Diameter 6 in. to ft., Dia in. to ft., Dia in. to ft. Casing height above land surface 30 in., weight lbs. / ft. Wall thickness or gauge No. TYPE OF SCREEN OR PERFORATION MATERIAL: 1 Steel 3 Stainless Steel 5 Fiberglass 7 PVC 10 Asbestos-cement 2 Brass 4 Galvanized steel 6 Concrete tile 9 ABS 11 other (specify) 12 None used (open hole) SCREEN OR PERFORATION OPENING ARE: 1 Continuous slot 3 Mill slot 5 Gauzed wrapped 8 Saw cut 11 None (open hole) 2 Louvered shutter 4 Key punched 6 Wire wrapped 9 Drilled holes 7 Torch cut 10 Other (specify) SCREEN-PERFORATION INTERVALS: from ft. to ft., From ft. to ft. GRAVEL PACK INTERVALS: from ft. to ft., From ft. to ft.				
6 GROUT MATERIAL: 1 Neat cement 2 Cement grout 3 Bentonite 4 Other Grout Intervals: From 0 ft. to 6 ft., From ft. to ft., From ft. to ft. What is the nearest source of possible contamination: 1 Septic tank 4 Lateral lines 7 Pit privy 10 Livestock pens 14 Abandon water well 2 Sewer lines 5 Cess pool 8 Sewage lagoon 11 Fuel storage 15 Oil well/Gas well 3 Watertight sewer lines 6 Seepage pit 9 Feedyard 12 Fertilizer storage 16 Other (specify below) 13 Insecticide storage Direction from well? South How many feet? 25				
FROM TO LITHOLOGIC LOG		FROM TO PLUGGING INTERVALS		
		0	6	cement grout
		6	20	bentonite hole plug
		20	67	chlorinated sand and gravel
		RECEIVED		
		MAY 07 1993		
		BUREAU OF WATER		
7 CONTRACTOR'S OR LANDOWNER'S CERTIFICATION: This water well was (1) constructed, (2) reconstructed, or (3) <u>plugged</u> under my jurisdiction and was completed on (mo/day/year) 03/10/1993 and this record is true to the best of my knowledge and belief. Kansas Water Well Contractor's License No. 236 This Water Well Record was completed on (mo/day/yr) 03/10/93 Under the business name of Harp Well & Pump Service, Inc by (signature) <i>Jane Frederick</i>				