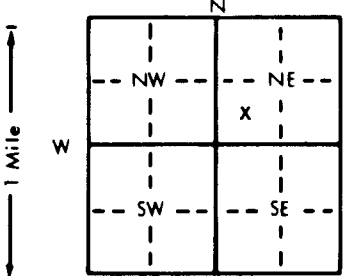


1 LOCATION OF WATER WELL:		Fraction		Section Number		Township Number		Range Number	
County: Sedgwick		SW 1/4 NE 1/4 NE 1/4		31		T 27 S		R 2 E(w)	
Distance and direction from nearest town or city street address of well if located within city?									
12' east of 425 Main Street, Goddard, KS					HWST Job No. 74-40/4034.01				
2 WATER WELL OWNER: Southwestern Bell Telephone									
RR#, St. Address, Box # : 220 East 6th St.									
City, State, ZIP Code : Topeka, KS 66603									
Board of Agriculture, Division of Water Resources									
Application Number:									
3 LOCATE WELL'S LOCATION WITH AN "X" IN SECTION BOX:		4 DEPTH OF COMPLETED WELL: 50.0 ft. ELEVATION: unknown							
		Depth(s) Groundwater Encountered 1. ft. 2. ft. 3. ft.							
		WELL'S STATIC WATER LEVEL 46 ft. below land surface measured on mo/day/yr 10/30/90							
		Pump test data: Well water was ft. after hours pumping gpm							
		Est. Yield gpm: Well water was ft. after hours pumping gpm							
		Bore Hole Diameter 6.0 in. to 50.0 ft. and in. to ft.							
WELL WATER TO BE USED AS:									
1 Domestic 3 Feedlot 6 Oil field water supply 9 Dewatering 12 Other (Specify below)									
2 Irrigation 4 Industrial 7 Lawn and garden only 10 Monitoring well MW-3									
Was a chemical/bacteriological sample submitted to Department? Yes No x If yes, mo/day/yr sample was submitted									
Water Well Disinfected? Yes No x									
5 TYPE OF BLANK CASING USED:									
1 Steel 3 RMP (SR) 5 Wrought iron 8 Concrete tile CASING JOINTS: Glued Clamped									
2 PVC 4 ABS 6 Asbestos-Cement 9 Other (specify below) Welded									
Blank casing diameter 2.0 in. to 40.0 ft., Dia in. to ft., Dia in. to ft.									
Casing height above land surface 37 in., weight lbs./ft. Wall thickness or gauge No. Sch. 40									
TYPE OF SCREEN OR PERFORATION MATERIAL:									
1 Steel 3 Stainless steel 5 Fiberglass 8 RMP (SR) 10 Asbestos-cement									
2 Brass 4 Galvanized steel 6 Concrete tile 9 ABS 12 None used (open hole)									
SCREEN OR PERFORATION OPENINGS ARE:									
1 Continuous slot 3 Mill slot 5 Gauzed wrapped 8 Saw cut 11 None (open hole)									
2 Louvered shutter 4 Key punched 6 Wire wrapped 9 Drilled holes									
7 Torch cut 10 Other (specify)									
SCREEN-PERFORATED INTERVALS: From 40.0 ft. to 50.0 ft., From ft. to ft.									
GRAVEL PACK INTERVALS: From 37.5 ft. to 50.0 ft., From ft. to ft.									
6 GROUT MATERIAL: 1 Neat cement 2 Cement grout 3 Bentonite 4 Other									
Grout Intervals: From 0 ft. to 37.5 ft., From ft. to ft., From ft. to ft.									
What is the nearest source of possible contamination:									
1 Septic tank 4 Lateral lines 7 Pit privy 10 Livestock pens 14 Abandoned water well									
2 Sewer lines 5 Cess pool 8 Sewage lagoon 11 Fuel storage 15 Oil well/Gas well									
3 Watertight sewer lines 6 Seepage pit 9 Feedyard 12 Fertilizer storage 16 Other (specify below)									
13 Insecticide storage diesel									
Direction from well? South How many feet? 10'									
FROM TO LITHOLOGIC LOG FROM TO PLUGGING INTERVALS									
0 4.0 Clay; dark brown, lean, dry, fill material									
4.0 11.0 Clay; dark brown and tan, slightly silty and sandy.									
11.0 15.0 Sandy Clay; red and tan, 10% fine to medium sand; subrounded and spherical									
15.0 28.0 Clay; gray, lean w/ calcareous nodules									
28.0 46.0 Sandy Clay; gray and tan, 15-29% fine to medium sand; subrounded and spherical.									
46.0 50.0 Sand; red, fine to coarse, poorly sorted subprismatic (coarse) to spherical (fine) well rounded.									
7 CONTRACTOR'S OR LANDOWNER'S CERTIFICATION: This water well was (x) constructed, (2) reconstructed, or (3) plugged under my jurisdiction and was completed on (mo/day/year) 11/30/90 and this record is true to the best of my knowledge and belief. Kansas Water Well Contractor's License No. 471A This Water Well Record was completed on (mo/day/yr) 12/7/90 under the business name of HWS Technologies Inc. by (signature) [Signature]									
INSTRUCTIONS: Use typewriter or ball point pen. PLEASE PRESS FIRMLY and PRINT clearly. Please fill in blanks, underline or circle the correct answers. Send top three copies to Kansas Department of Health and Environment, Bureau of Water, Topeka, Kansas 66620-7320. Telephone: 913-296-5545. Send one to WATER WELL OWNER and retain one for your records.									